

WELL PLUGGING RECORD

Give All Information Completely  
Make Required Affidavit  
Mail or Deliver Report to:  
Conservation Division  
State Corporation Commission  
211 No. Broadway  
Wichita, Kansas

COMANCHE

County. Sec. 7 Twp. 34 Rge. (E) 19 (W)

Location as "NE/CNW%SW%" or footage from lines SE/4 NW/4 NW/4

Lease Owner L. B. JACKSON CO.

Lease Name PETRO Well No. 1

Office Address 503 MAYO BLDG., TULSA, OKLAHOMA

Character of Well (completed as Oil, Gas or Dry Hole) DRY HOLE

Date well completed 1-21-1963

Application for plugging filed 1-30-1963

Application for plugging approved 2-1-1963


Plugging commenced 2-2-1963

Plugging completed 2-5-1963

Reason for abandonment of well or producing formation DRY

If a producing well is abandoned, date of last production 19

Was permission obtained from the Conservation Division or its agents before plugging was commenced? YES

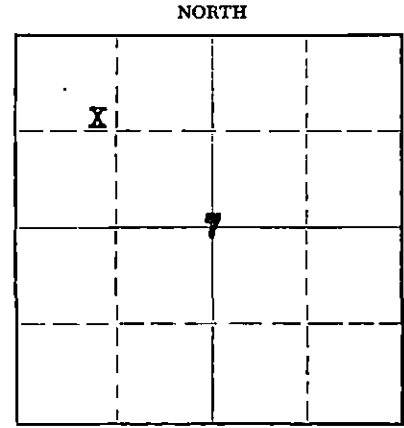

Locate well correctly on above Section Plat

Name of Conservation Agent who supervised plugging of this well ARCHIE ELVING

Producing formation NONE Depth to top Bottom Total Depth of Well 6313 Feet

Show depth and thickness of all water, oil and gas formations.

OIL, GAS OR WATER RECORDS

CASING RECORD

FORMATION	CONTENT	FROM	TO	SIZE	PUT IN	PULLED OUT
SAND	WATER	100'	150'			
MISS. CHAT	DRY	5200'	5218'	8 5/8	369'	NONE
MISS. LIME	DRY	5258'	5282'			
MISS. LIME	DRY	5360'	5370'	5 1/2	5650'	4370'
MISS. LIME	DRY	5426'	5436'			

Describe in detail the manner in which the well was plugged, indicating where the mud fluid was placed and the method or methods used in introducing it into the hole. If cement or other plugs were used, state the character of same and depth placed, from feet to feet for each plug set.

SET 5 1/2" BAKER PLUGS AS FOLLOWS: 5400'; 5320'; 5245';  
PLUGGED BACK FROM 5245 TO 5200 WITH SAND PLACED (5) FIVE SACKS CEMENT AT 5200'. PULLED 4370' 5 1/2" CASING; FILLED HOLE WITH MUD TO 350'. SET 10' ROCK BRIDGE FROM 350' TO 340' PLACED 20 SACKS CEMENT AT 340'. FILLED WITH MUD TO 30'. SET 10' ROCK BRIDGE FROM 30' TO 20' PLACED 10 SACKS CEMENT AT 20', FILLED TO SURFACE FOR CAP.

STATE OF KANSAS  
STATE CORPORATION COMMISSION

FEB 18 1963

2-18-63

CONSERVATION DIVISION  
Wichita, Kansas

(If additional description is necessary, use BACK of this sheet)

Name of Plugging Contractor FORBES CASING, INC.

Address BOX 221, GREAT BEND, KANSAS

STATE OF \_\_\_\_\_, COUNTY OF \_\_\_\_\_, ss.

(employee of owner) or (owner or operator) of the above-described well, being first duly sworn on oath, says: That I have knowledge of the facts, statements, and matters herein contained and the log of the above-described well as filed and that the same are true and correct. So help me God.

(Signature) Curtis Young  
CURTIS YOUNG, P. O. BOX 747, SAPULPA, OKLA.  
(Address)

SUBSCRIBED AND SWORN TO before me this 5 day of February, 1963

Hattie Mae Burns  
Notary Public.

My commission expires July 25, 1964



15-033-00087-0000

70

**LOG**

Top	Bottom	Formation and Remarks
0	5	SOIL
5	100	SHALE
100	150	SAND
150	200	SHALE
200	369	RED BED & ANHYDRITE
369	2124	RED BED & ANHYDRITE
2124	2972	ANHYDRITE
2972	3172	SHALE & SANDY SHALE
3172	3339	SHALE & ANHYDRITE
3339	3493	ANHYDRITE STREAKS & CHALK
3493	3554	LIME & SHALE
3554	4371	SHALE & ANHYDRITE
4371	4382	BROWN LIME
4382	4414	SHALE
4414	4424	LANSING
4424	4619	LIME W/ SHALE STREAKS
4619	4695	LIME & CHALK STREAKS
4695	4733	LIME
4733	4846	LIME & SHALE
4846	4875	LIME & CHALK STREAKS
4875	5029	LIME & SHALE
5029	5067	LIME & BLACK SHALE
5067	5095	LIME
5095	5189	LIME & SHALE STREAKS
5189	5200	SHALE & LIME W/SAND
5200	5260	MISSISSIPPI CHAT
5260	5560	MISSISSIPPI LIME
5560	5739	LIME CHLKY.
5739	5766	LIME & CHERT
5766	6060	LIME
6060	6080	SHALE & CHERT
6080	6084	VIOLA LIME
6084	6230	DOLOMITE LIGHT GRAY
6230	6313	DOLOMITE BROWN WITH SOME BROWN CHERT
6313		TOTAL DEPTH

DESCRIPTION		SE/4 NW/4 NW/4	
State	KANSAS	Company	L. B. JACKSON CO.
County	COMANCHE	Farm	PETRO
		Well No.	#1
Survey		SEC. 7 - 345 - 19 W	
T.	R.	Contractor	L. B. JACKSON CO.
		Commenced	11-2-62
		Completed	1-21-63
		Remarks	DRY & ABANDONED
Altitude		ELEV. D. F. 1817'	
Production		ELEV. GR. 1807'	
CASING RECORD			
		10 "	
		<del>8 5/8"</del> 8 5/8"	369'
20 "		6 5/8"	
15 1/2"		<del>5 1/2"</del> 5 1/2"	5650'
12 1/2"			
Shot	Quarts	Between	

Log--Continued		
Top	Bottom	Formation and Remarks
28#	L. W.	8 5/8" CASING 369' CEMENTED WITH 250 SACKS
15 1/2#	J-55	5 1/2" CASING 5650' CEMENTED WITH 160 SACKS.
PERFORATIONS:		
FORMATIONS:	FROM	TO NO. OF HOLES
MISS. CHAT	5200'	5218' 72
MISS. LIME	5258'	5282' 96
MISS. LIME	5360'	5370' 40
MISS. LIME	5426'	5436' 40
ACIDIZED - MISS. LIME FROM 5200' TO 5218' WITH 500 GAL. ACID.		
SET BAKER PLUGS @ 5400'		
	"	" " 5320'
	"	" " 5245'

ROSS-MARTIN CO. TULSA, OKLAHOMA

RECEIVED  
STATE CORPORATION

MAR 25 1963

3-25-63  
CONSERVATION  
Wichita, Kansas

