


WELL PLUGGING RECORD

Give All Information Completely
Make Required Affidavit
Mail or Deliver Report to:
Conservation Division
State Corporation Commission
211 No. Broadway
Wichita, Kansas

Comanche County. Sec. 12 Twp. 34S Rge. (E) 19(W)
Location as "NE/CNW4SW4" or footage from lines NE NE
Lease Owner Hall-Jones Oil Corporation
Lease Name Oller Well No. 1
Office Address 1710 Liberty Bank Building, Oklahoma City, Okla.
Character of Well (completed as Oil, Gas or Dry Hole) Dry Hole
Date well completed 8-14 19 65
Application for plugging filed 19
Application for plugging approved 19
Plugging commenced 8-16 19 65
Plugging completed 8-16 19 65
Reason for abandonment of well or producing formation Dry Hole

NORTH

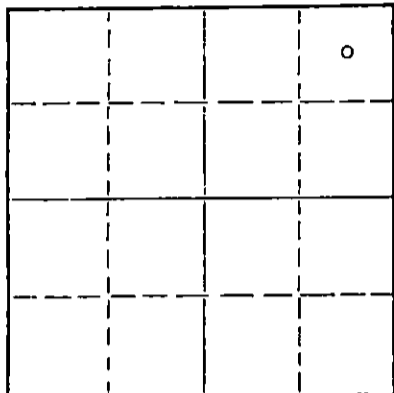

Locate well correctly on above
Section Plat

If a producing well is abandoned, date of last production 19
Was permission obtained from the Conservation Division or its agents before plugging was commenced? Yes

Name of Conservation Agent who supervised plugging of this well Mr. Archie Elving
Producing formation Depth to top Bottom Total Depth of Well 6,339 Feet
Show depth and thickness of all water, oil and gas formations.

OIL, GAS OR WATER RECORDS

CASING RECORD

FORMATION	CONTENT	FROM	TO	SIZE	PUT IN	PULLED OUT
				8-5/8"	470'	None

Describe in detail the manner in which the well was plugged, indicating where the mud fluid was placed and the method or methods used in introducing it into the hole. If cement or other plugs were used, state the character of same and depth placed, from feet to feet for each plug set.

Placed 20 sacks of cement from 300' to 225' and 20 sacks
of cement from 40' to surface.

RECEIVED
STATE CORPORATION COMMISSION

AUG 20 1965
8-20-65
CONSERVATION DIVISION
Wichita, Kansas

(If additional description is necessary, use BACK of this sheet)

Name of Plugging Contractor Garvey Drilling Company
Address Rural Route #2, Great Bend, Kansas

STATE OF Oklahoma, COUNTY OF Oklahoma, ss.
Ralph Adams (employee of owner) or (owner or operator) of the above-described well, being first duly sworn on oath, says: That I have knowledge of the facts, statements, and matters herein contained and the log of the above-described well, as filed and that the same are true and correct. So help me God.

(Signature) Ralph Adams
1710 Liberty Bank Building, Okla. City, Okla.
(Address)

SUBSCRIBED AND SWORN TO before me this 19 th day of August, 19 65

My commission expires December 31, 1968

Norma Jones
Notary Public.

WELL LOG

15-033-30004-0000

COMPANY Hall - Jones Corporation

SEC. 12 T. 34S R. 19W

FARM Oller

NO. 1

LOC. NE NE


TOTAL DEPTH 6339'

COUNTY Comanche

COMM. 7-23-65

COMP. 8-15-65

CONTRACTOR Garvey Drilling Company

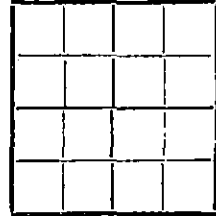

CASING 16" w/160 sx

8 5/8" @ 470' w/250 sx

ELEVATION

PRODUCTION D & A

FIGURES INDICATE BOTTOM OF FORMATIONS

369' Red Bed and Gyp
 1850' Red Bed
 2128' Shale and Gyp Stringers
 2135' Gyp
 2365' Shale and Lime
 2590' Lime
 2725' Dolomite
 2840' Lime
 3130' Lime and Shale
 3360' Shale and Lime
 3895' Lime and Shale
 4125' Shale and Lime
 4455' Lime and Shale
 5303' Lime
 5352' Lime and Chert
 5712' Lime
 5745' Lime (Cherty)
 6260' Lime
 6310' Lime and Chert
 6314' Sand and Dolomite
 6339' Lime
 6339' RTD

RECEIVED
STATE CORPORATION COMMISSION

AUG 25 1965
8-25-65
CONSERVATION DIVISION
Wichita, Kansas

State of Kansas
County of Barton } 85

I, Sam N. Stephens of Garvey Drilling Company

upon oath state the above and foregoing is a true and correct copy of the log of the Oller #1 well.

Sam N. Stephens

Subscribed and sworn to before me this 20th day of August 19 65

My Commission Expires: May 28, 1969

Richard W. D. ...
NOTARY PUBLIC