

15-033-20340-0000

STATE OF KANSAS  
STATE CORPORATION COMMISSION

WELL PLUGGING RECORD


RECEIVED  
STATE CORPORATION COMMISSION  
1 AUG - 8 1980  
CONSERVATION DIVISION  
Wichita, Kansas

Give All Information Completely  
Make Required Affidavit  
Mail or Deliver Report to  
Conservation Division  
State Corporation Comm.  
245 North Water  
Wichita, KS 67202

COMANCHE County. Sec. 18 Twp. 34S Rge. 19W ~~EX~~/W  
Location as "NE/CNW $\frac{1}{4}$ /SW $\frac{1}{4}$ " or footage from lines  
C SE/4

Lease Owner Lear Petroleum Exploration, Inc.  
Lease Name Hackney Well No. #1  
Office Address 2601 NW Expressway, 1200W, Okla. City, OK  
Character of Well (Completed as Oil, Gas or Dry Hole) Dry Hole

Date Well completed 3/30 1980  
Application for plugging filed 7/15 1980  
Application for plugging approved 7/21 1980  
Plugging commenced 7/28 1980  
Plugging completed 7/30 1980  
Reason for abandonment of well or producing formation No production (Gas TSTM)

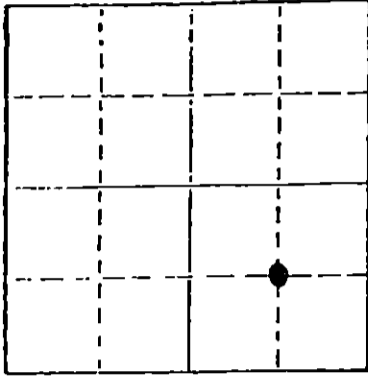

Locate well correctly on above Section Plot

If a producing well is abandoned, date of last production 1980

Was permission obtained from the Conservation Division or its agents before plugging was commenced? YES

Name of Conservation Agent who supervised plugging of this well William T. Owen  
Producing formation None Depth to top          Bottom          Total Depth of Well 5599'  
Show depth and thickness of all water, oil and gas formations.

OIL, GAS OR WATER RECORDS

CASING RECORD

FORMATION	CONTENT	FROM	TO	SIZE	PUT IN	PULLED OUT
				8-5/8"	665'	NONE
				4 1/2"	5524'	3238'

Describe in detail the manner in which the well was plugged, indicating where the mud fluid was placed and the method or methods used in introducing it into the hold. If cement or other plugs were used, state the character of same and depth placed, from          feet to          feet for each plug set.

Pulled tbg. Spotted 35 sxs cmt plug from 5220-5200'. Rec 86 jts 4 1/2" esg @ 3238'. Pmpd 40 sxs cmt plug @ 900', 40 sxs @ 630' & 10 sxs @ surface. Cut off surface pipe 4' below ground level & welded on steel name plate.

(If additional description is necessary, use BACK of this sheet)

Name of Plugging Contractor Lillard Casing Pullers - Woodward, Oklahoma

STATE OF OKLAHOMA COUNTY OF OKLAHOMA, ss.  
R. Stanley DeLong (employee of owner) or (owner or operator)

of the above-described well, being first duly sworn on oath, says: That I have knowledge of the facts, statements, and matters herein contained and the log of the above-described well as filed and that the same are true and correct. So help me God.

(Signature) R. Stanley DeLong  
2601 N. W. Expressway, Suite 1200 W, OKC  
(Address) 73112

SUBSCRIBED AND SWORN TO before me this 5 day of August, 19 80

Sharla D. Brady  
Notary Public.

My commission expires 2/19/84