


STATE OF KANSAS
STATE CORPORATION COMMISSION

WELL PLUGGING RECORD

Give All Information Completely
Make Required Affidavit
Mail or Deliver Report to
Conservation Division
State Corporation Comm.
245 North Water
Wichita, KS 67202

Comanche County, Sec. 18 Twp. 34S Rge. 19 N/W
Location as "NE/CNW $\frac{1}{4}$ SW $\frac{1}{4}$ " or footage from lines 660 FWL and 660 FSL
Lease Owner InterNorth, Inc.
Lease Name Petro "A" 18 Well No. 1
Office Address P. O. Box 35288, Tulsa, OK. 74153
Character of Well (Completed as Oil, Gas or Dry Hole) Dry Hole
Date Well completed 19__
Application for plugging filed April 28 1983
Application for plugging approved June 13 1983
Plugging commenced June 20 1983
Plugging completed June 22 1983
Reason for abandonment of well or producing formation Non-commercial
If a producing well is abandoned, date of last production 19__
Was permission obtained from the Conservation Division or its agents before plugging was commenced? yes

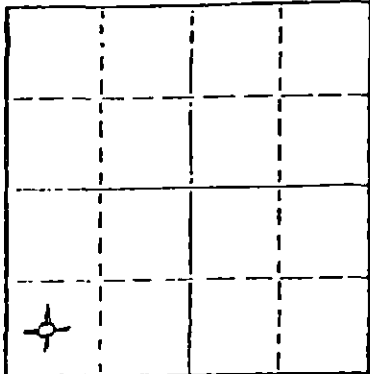

Locate well correctly on above Section Plat

Name of Conservation Agent who supervised plugging of this well
Producing formation Swope Depth to top 4805 Bottom 4810 Total Depth of Well 4950
Show depth and thickness of all water, oil and gas formations.

OIL, GAS OR WATER RECORDS

CASING RECORD

FORMATION	CONTENT	FROM	TO	SIZE	PUT IN	PULLED OUT
Council Grove	Lime	2706'	3106'	8 5/8	606	NONE
Stotler	Lime	3371'	3593'	4 1/2	4940	3017
Douglas	Sand	4225'	4391'			
Lansing	Lime	4391'	4794'			
Swope	Lime	4794'	4843'			

Describe in detail the manner in which the well was plugged, indicating where the mud fluid was placed and the method or methods used in introducing it into the hole. If cement or other plugs were used, state the character of same and depth placed, from feet to feet for each plug set.

Set CIBP @ 4780'. Dump 2 sks. cmt. on top. Shot pipe @ 3017'. Circulate hole via csg. with 9.5 PPG, 38 vis. mud. Pull csg. to 650'. Pump cmt. plug from 650' to 3' using 210 sks. cement with 25 sks. gel and 4 sks. cotton seed hulls. Welded on steel plate with name and date.

(If additional description is necessary, use BACK of this sheet)

Name of Plugging Contractor Mike Proctor's Casing Pullers, Inc.

STATE OF Oklahoma COUNTY OF Tulsa, ss.

C. B. Lackey (employee of owner) or (owner or operator) of the above-described well, being first duly sworn on oath, says: That I have knowledge of the facts, statements, and matters herein contained and the log of the above-described well as filed and that the same are true and correct. So help me God

(Signature) C.B. Lackey
P. O. Box 35288, Tulsa, Ok. 74153
(Address)

SUBSCRIBED AND SWORN TO before me this 12th day of July, 1983

Annette L. Schwanin
Notary Public.

My commission expires My Commission Expires March 7, 1987

RECEIVED
STATE CORPORATION COMMISSION

JUL 15 1983
7-15-83
CONSERVATION DIVISION
Wichita, Kansas