

15-833-10015-0000

STATE OF KANSAS  
STATE CORPORATION COMMISSION

Form CP-4

Give All Information Completely  
Make Required Affidavit  
Mail or Deliver Report to:  
Conservation Division  
State Corporation Commission  
211 No. Broadway  
Wichita, Kansas

WELL PLUGGING RECORD

Comanche County, Sec. 24 Twp. 33S Rge. 17W (X) (W)

Location as "NE/CNW/SW" or footage from lines 660' f/N & 660' f/E lines

Lease Owner Continental Oil Company

Lease Name Shimer "A" Gas Unit Well No. 1

Office Address Box 30, Lyons, Kansas

Character of Well (completed as Oil, Gas or Dry Hole) Dry Hole

Date well completed 11-17 19 62

Application for plugging filed 11-17-19 62

Application for plugging approved 11-17-19 62


Plugging commenced 11-18-19 62

Plugging completed 11-18-19 62

Reason for abandonment of well or producing formation Dry Hole

If a producing well is abandoned, date of last production 19

Was permission obtained from the Conservation Division or its agents before plugging was commenced? Yes

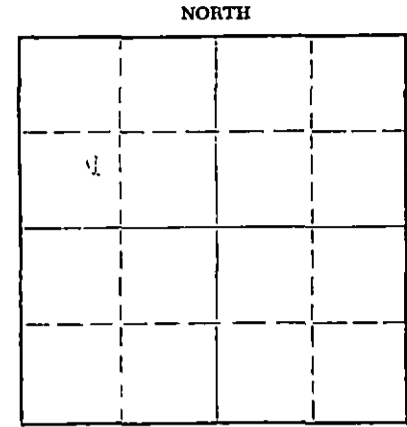

Locate well correctly on above Section Flat

Name of Conservation Agent who supervised plugging of this well W. L. Lackamp, R. R. #1, Stafford, Kansas

Producing formation Depth to top Bottom Total Depth of Well 5072 Feet

Show depth and thickness of all water, oil and gas formations.

OIL, GAS OR WATER RECORDS

CASING RECORD

FORMATION	CONTENT	FROM	TO	SIZE	PUT IN	PULLED OUT
Red Bed, Gyp Rock, & Shale	Surface Csg.	-0-	396'	10 3/4"	396'	None

Describe in detail the manner in which the well was plugged, indicating where the mud fluid was placed and the method or methods used in introducing it into the hole. If cement or other plugs were used, state the character of same and depth placed, from feet to feet for each plug set.

Filled hole with heavy mud from 5072' to 375'; set 25-sack cement plug at 375'; filled hole with heavy mud to 35', set 10-sack cement plug to surface. Completed 11-18-62.

RECEIVED  
STATE CORPORATION COMMISSION

DEC 21 1962

12-21-62

CONSERVATION DIVISION  
Wichita, Kansas

(If additional description is necessary, use BACK of this sheet)

Name of Plugging Contractor Strata Drilling, Inc.  
Address Box 355, Great Bend, Kansas

STATE OF KANSAS, COUNTY OF RICE, ss.  
I, W. S. AKERS, (employee of owner) of the above-described well, being first duly sworn on oath, says: That I have knowledge of the facts, statements, and matters herein contained and the log of the above-described well as filed and that the same are true and correct. So help me God.

(Signature) [Signature]

Box 30, Lyons, Kansas  
(Address)

SUBSCRIBED AND SWORN to before me this 19th day of December, 1962

My commission expires May 5, 1965

Notary Public.

DRILLERS LOG

#1 Shiner "A" Gas Unit

CASING RECORD: 396' 10-3/4" surface casing  
 COMPANY: Continental Oil Company  
 DESCRIPTION: NE NE Section 24-33S-17W Comanche County, Kansas  
 CONTRACTOR: Strata Drilling, Inc.

TOTAL DEPTH: 5072'  
 COMMENCED: November 1, 1962  
 ELEVATION: 1840' DF  
 COMPLETED: November 18, 1962

D. & A.

<u>FORMATION</u>	<u>FROM</u>	<u>TO</u>	<u>REMARKS</u>
Red Bed	0	40	Ran 396' of 10-3/4" surface casing; set and cemented at 396' with 300 sacks of common cement, 2% C. C.. Plug down at 11:45 P. M. November 3, 1962.  NEC STATE CORPORATION CO  DEC 26 1962 12-26-62 CONSERVATION DIVISION Wichita, Kansas
Gyp Rock	40	130	
Red Bed	130	434	
Shale - Red Bed	434	640	
Shale & Shells	640	1320	
Shale & Lime	1320	2010	
Shale w/Lime Streaks	2010	2225	
Lime	2225	2380	
Lime & Shale	2380	2505	
Lime	2505	2625	
Lime & Shale	2625	3595	
Lime	3595	3665	
Lime & Shale	3665	4320	
Shale	4320	4333	
Lime	4333	4788	
Lime & Shale	4788	4893	D. & A.
Lime	4893	4963	
Lime & Shale	4963	5040	
Lime	5040	5057	
Lime & Shale	5057	5072	Plugged as follows: plugged at 375' with 25 sacks of cement to 35'; plugged with 10 sacks of cement. Job completed at November 18, 1962.
Total Depth 5072'			

STATE OF KANSAS )  
 ) ss.  
 COUNTY OF BARTON )

I certify that this is a true and correct copy of the above log to the best of my knowledge.

STRATA DRILLING, INC.

*Jim B. McWilliams*  
 Jim B. McWilliams, Secy-Treas.

Subscribed and sworn to before me this 19th day of November, 1962.

*Elaine H. Taylor*  
 Elaine H. Taylor, Notary Public

My Commission Expires:  
 December 14, 1965







51-15-51

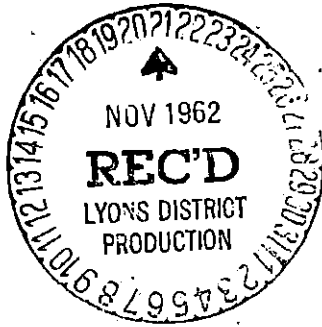

[Illegible text]