


15-033-20017-0000

Give All Information Completely
Make Required Affidavit
Mail or Deliver Report to:
Conservation Division
State Corporation Commission
211 No. Broadway
Wichita, Kansas

WELL PLUGGING RECORD

NORTH

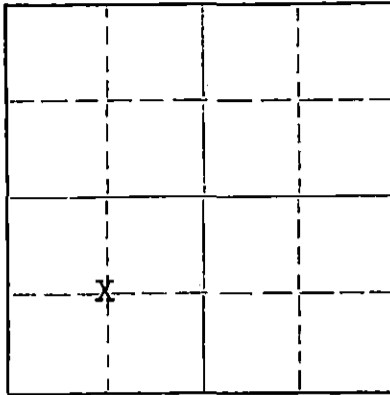

Locate well correctly on above
Section Plat

Comanche County, Sec. 13 Twp. 33S Rge. (E) 17 (W)
Location as "NE/CNWSW" or footage from lines C SW/4
Lease Owner J. M. Huber Corporation
Lease Name Einsel-Biddle Well No. 3
Office Address 5415 North Pennsylvania, Okla. City, Okla.
Character of Well (completed as Oil, Gas or Dry Hole) Dry
Date well completed 10/29 1967
Application for plugging filed 10/29 1967
Application for plugging approved 10/29 1967
Plugging commenced 10/29 1967
Plugging completed 10/29 1967
Reason for abandonment of well or producing formation Dry

If a producing well is abandoned, date of last production 19
Was permission obtained from the Conservation Division or its agents before plugging was commenced? Yes

Name of Conservation Agent who supervised plugging of this well Archie Elving
Producing formation None Depth to top Bottom Total Depth of Well 5165 Feet
Show depth and thickness of all water, oil and gas formations.

OIL, GAS OR WATER RECORDS

CASING RECORD

FORMATION	CONTENT	FROM	TO	SIZE	PUT IN
				8-5/8"	NOV 8 1967 11-8-67 CONSERVATION DIVISION Wichita, Kansas

Describe in detail the manner in which the well was plugged, indicating where the mud fluid was placed and the method or methods used in introducing it into the hole. If cement or other plugs were used, state the character of same and depth placed, from feet to feet for each plug set.

The hole was filled with mud, pushed plug with 1/2 sack of hulls on top of plug. Spotted 25 sacks of cement. Filled hole with mud to 40 feet. Set plug with 1/2 sack hulls at 40 feet. Set 10 sacks cement in plug from 40 to 10 feet. Casing was cut off 4 feet below ground level. Rathole plugged with 2 sacks cement.

(If additional description is necessary, use BACK of this sheet)

Name of Plugging Contractor Leben Drilling, Inc.
Address P. O. Box 486, Great Bend, Kansas, 67530

STATE OF Oklahoma, COUNTY OF Oklahoma, ss.
Warren W. Henson (employee of owner) or (owner or operator) of the above-described well, being first duly sworn on oath, says: That I have knowledge of the facts, statements, and matters herein contained and the log of the above-described well as filed and that the same are true and correct. So help me God.

(Signature) Warren W. Henson
Warren W. Henson, Dist. Prod. Supt.
5415 North Pennsylvania, Okla. City, Okla.
(Address)

SUBSCRIBED AND SWORN TO before me this 3rd day of November, 1967

My commission expires 1/9/69

Notary Public.

DRILLER'S LOG

COMPANY: J. M. Huber Corporation
 CONTRACTOR: LEBEN DRILLING, INC.
 FARM: EINSEL-BIDDLE #3
 LOCATION: C SW SECTION 13-33S-17W
 COMANCHE COUNTY, KANSAS
 COMMENCED: 10-16-67
 COMPLETED: 10-29-67

0	365	Redbed
365	1160	Redbed, Shale
1160	1500	Shale
1500	2137	Shale, Shells
2137	2428	Lime
2428	2645	Lime, Shale
2645	3090	Lime
3090	4330	Lime, Shale
4330	5165	Lime
	<u>5165</u>	<u>RTD - D. & A.</u>

RECEIVED
 STATE CORPORATION COMMISSION
 NOV 2 1967
 11-2-67
 CONSERVATION DIVISION
 Wichita, Kansas

8 5/8" new 24# surface casing set @ 412' cemented with 300 sacks of Posmix, 2% gel, 2% cc, + 100 sks. Common, 2% cc

I, Leslie Kite, do hereby certify that the above and foregoing is a true and correct copy of the log of the Einsel-Biddle #3 Well, located C SW of Section 13, Township 33 South, Range 17 West, Comanche County, Kansas, as reflected by the records of Leben Drilling, Inc.

Leslie Kite
 Leslie Kite

STATE OF KANSAS)
 COUNTY OF BARTON) SS

Subscribed and sworn to and before me, a Notary Public, in and for Barton County, Kansas, this 31st day of October, 1967.

Ulanda Nichols
 Ulanda Nichols

My Commission Expires:
 April 1, 1971