


Give All Information Completely
Make Required Affidavit
Mail or Deliver Report to:
Conservation Division
State Corporation Commission
212 No. Market
Wichita, Kansas

WELL PLUGGING RECORD

Comanche County. Sec. 13 Twp. 34 Rge. 16 (E) W (W)
Location as "NE/CNW/SW" or footage from lines 6 NW SE
Lease Owner Shenandoah Oil Corp.
Lease Name Merrill Ranch D Well No. 1
Office Address 1018 Commerce Bldg., Fort Worth, Texas
Character of Well (completed as Oil, Gas or Dry Hole) Dry Hole
Date well completed 8/19 19 68
Application for plugging filed 8/19 19 68
Application for plugging approved 8/19 19 68
e Plugging commenced 8/19 19 68
Plugging completed 8/19 19 68
Reason for abandonment of well or producing formation Dry hole

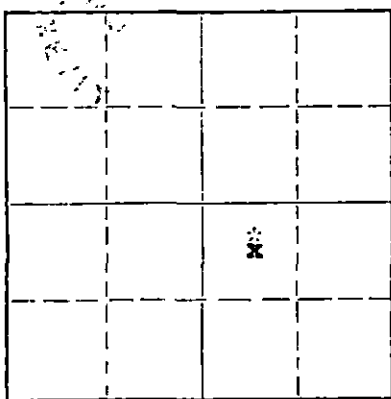

Locate well correctly on above Section Plat

If a producing well is abandoned, date of last production 19
Was permission obtained from the Conservation Division or its agents before plugging was commenced? yes

Name of Conservation Agent who supervised plugging of this well Ralph Waren
Producing formation _____ Depth to top _____ Bottom _____ Total Depth of Well _____ Feet
Show depth and thickness of all water, oil and gas formations.

OIL, GAS OR WATER RECORDS

CASING RECORD

FORMATION	CONTENT	FROM	TO	SIZE	PUT IN	PULLED OUT
Surface pipe		-0-	1029	8 5/8"	1029'	-0-

Describe in detail the manner in which the well was plugged, indicating where the mud fluid was placed and the method or methods used in introducing it into the hole. If cement or other plugs were used, state the character of same and depth placed, from _____ feet to _____ feet for each plug set.

Filled hole with heavy mud.
#1 plug @ 300' with 25 sks cement
#2 plug @ 40' with 10 sks cement
3# plug in rat hole with 2 sks. cement

RECEIVED
STATE CORPORATION COMMISSION
AUG 27 1968
CONSERVATION DIVISION
Wichita, Kansas


(If additional description is necessary, use BACK of this sheet)

Name of Plugging Contractor Sweetman Drilling, Inc.
Address Box 645, Great Bend, Kansas 67530

STATE OF Kansas COUNTY OF Barton, ss.
T. D. Sweetman (employee of owner) or (owner or operator) of the above-described well, being first duly sworn on oath, says: That I have knowledge of the facts, statements, and matters herein contained and the log of the above-described well as filed and that the same are true and correct. So help me God.

(Signature) T. D. Sweetman Pres.
Box 645, Great Bend, Kns.
(Address)

SUBSCRIBED AND SWORN to before me this 26th day of August, 19 68
Reata L. Boyd
Notary Public.

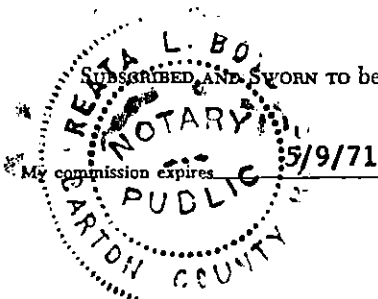

15-833-20031-0000

WELL LOG

Merrill Ranch D#1
C NW SE
13-34-16W
Comanche County, Kansas

ELEVATION: 1641 KB

FROM	TO	
0	434	Sub soil and red beds
434	550	Red beds
550	746	Red bed and shaled sand
746	1255	Red bed and shale
1255	2180	Shale and shells
2180	4365	Lime and shale
4365	4494	Lime
4494	4568	Lime and shale
4568	4935	Lime
4935	5017	Lime and shale
5017	5050	Lime
5050		Total depth.

RECEIVED
STATE CORPORATION COMMISSION
AUG 27 1968
CONSERVATION DIVISION
Wichita, Kansas

STATE OF KANSAS
COUNTY OF BARTON ss

T. D. Sweetman, President of Sweetman Drilling, Inc., being first duly sworn on oath says: That I have knowledge of the facts, statements and matters herein contained and the log of the above described well as filed and that the same are true and correct.

T. D. Sweetman
T. D. Sweetman

and sworn before me this 26 Day of August, 1968

Henry L. Boyd
Notary Public - Barton County

