
15-033-00104-0000

STATE OF KANSAS
STATE CORPORATION COMMISSION

Give All Information Completely
Make Required Affidavit
Mail or Deliver Report to:
Conservation Division
State Corporation Commission
211 No. Broadway
Wichita, Kansas

WELL PLUGGING RECORD

NORTH

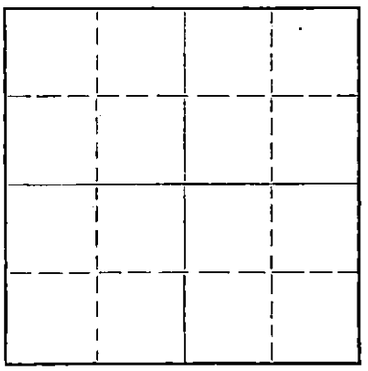

Locate well correctly on above Section Plat

Comanche County. Sec. 25 Twp. 34-S Rge. ____ (E) 16 (W)

Location as "NE/CNW¼SW¼" or footage from lines C NE/4 SW/4

Lease Owner Aladdin Petroleum Corp.

Lease Name McMoran Well No. 1

Office Address 809 Petroleum Building, Wichita 2, Kansas

Character of Well (completed as Oil, Gas or Dry Hole) Oil

Date well completed December 6 1960

Application for plugging filed May 20 1961

Application for plugging approved May 23 1961

Plugging commenced May 23 1961

Plugging completed May 27 1961

Reason for abandonment of well or producing formation Not profitable

If a producing well is abandoned, date of last production February 19 61

Was permission obtained from the Conservation Division or its agents before plugging was commenced? yes

Name of Conservation Agent who supervised plugging of this well W. L. LacKamp

Producing formation ____ Depth to top ____ Bottom ____ Total Depth of Well 5945 Feet

Show depth and thickness of all water, oil and gas formations.

OIL, GAS OR WATER RECORDS — CASING RECORD

FORMATION	CONTENT	FROM	TO	SIZE	PUT IN	PULLED OUT
				8-5/8"	900'	none
				5-1/2"	5083'	3996'

Describe in detail the manner in which the well was plugged, indicating where the mud fluid was placed and the method or methods used in introducing it into the hole. If cement or other plugs were used, state the character of same and depth placed, from ____ feet to ____ feet for each plug set.

Chat 4766 to 4750, 5 sacks cement 4750 to 4720
Shot 5-1/2" at 4200, 4093, 3984, mudded 4720 to 400
rock bridge 400 to 390, 20 sacks cement 390 to 330
mudded 330 to 35 - rock and 10 sacks cement 35 to base of cellar

RECEIVED
STATE CORPORATION COMMISSION
JUN 8 1961
6-8-61
CONSERVATION DIVISION
Wichita, Kansas

(If additional description is necessary, use BACK of this sheet)

Name of Plugging Contractor Glenn & Smith Pipe Pulling Co.

Address Box 114 - Ellinwood, Kansas

STATE OF Kansas, COUNTY OF Sedgwick, ss.

Jerome M. Johnson (employee of owner) or (owner or operator) of the above-described well, being first duly sworn on oath, says: That I have knowledge of the facts, statements, and matters herein contained and the log of the above-described well as filed and that the same are true and correct. So help me God.

(Signature) ALADDIN PETROLEUM CORPORATION
Jerome M. Johnson
(Address) Vice-President

SUBSCRIBED AND SWORN TO before me this 7th day of June, 19 61

Adela Petrik
Notary Public.

My commission expires Nov. 5, 1962

6441

15-033-00104-0000

McMORAN #1 (Deepening)
C NE NE SW Sec. 25-34S-16W
COMANCHE COUNTY, KANSAS

Date Comm: 6-24-60
Date Comp: 7-6-60

FORMATION RECORD

5130	- 5155	Lime
5155	- 5198	Lime and shale
5190	- 5240	Shale and lime
5240	- 5553	Lime
5553	- 5573	Lime and chert
5573	- 5608	Lime
5608	- 5644	Sand
5644	- 5685	Lime and sand
5685	- 5820	Lime
5820	- 5910	Lime
	5910	T.D.

RECEIVED
STATE CORPORATION COMMISSION
SEP 7 1962
9-7-62
CONSERVATION DIVISION
Wichita, Kansas

CASING RECORD

7-6-60 Ran 155 jts. 5½" 15.5 J-55 casing set @ 5083' K.B. w/150 sacks Pozmix. Plug down @ 9:30.