

15-033-10039-0000


STATE OF KANSAS
STATE CORPORATION COMMISSION

WELL PLUGGING RECORD
OR
FORMATION PLUGGING RECORD

Strike out upper line
when reporting plugging
of formations.

Give All Information Completely
Make Required Affidavit
Mail or Deliver Report to:
Conservation Division
State Corporation Commission
800 Bitting Building
Wichita, Kansas

NORTH

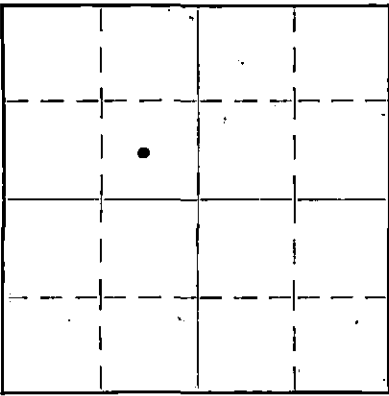

Locate well correctly on above
Section Plat

Location as "NE 1/4 NW 1/4 SW 1/4" or footage from lines SE 1/4 NW 1/4
Comanche County. Sec. 25 Twp. 34S Rge. (E) 16 (W)
Lease Owner Indian Territory Illuminating Oil Co.
Lease Name McMoran Well No. 1
Office Address Bartlesville, Oklahoma
Character of Well (Completed as Oil, Gas or Dry Hole) dry hole
Date, well completed August 28, 1939 193
Application for plugging filed 193
Application for plugging approved 193
Plugging Commenced August 29, 1939 193
Plugging Completed " " " 193
Reason for abandonment of well or producing formation dry hole

If a producing well is abandoned, date of last production 193
Was permission obtained from the Conservation Division or its agents before plugging was commenced?
Yes

Name of Conservation Agent who supervised plugging of this well
Producing formation Depth to top Bottom Total Depth of Well 5806 Feet.

Show depth and thickness of all water, oil and gas formations.
OIL, GAS OR WATER RECORDS

(T.D. taken from W.D.'s report)
CASING RECORD


Formation	Content	From	To	Size	Put In	Pulled Out

Describe in detail the manner in which the well was plugged, indicating where the mud fluid was placed and the method or methods used in introducing it into the hole. If cement or other plugs were used, state the character of same and depth placed, from feet to feet for each plug set.

Plug set at 5100', cemented with 25 sacks; hole pumped full of heavy mud and plugged at 1060' with 25 sacks cement

copy sent

PLUGGING
FILE NO. 25-34-16-1W
BOOK PAGE 74 LINE 16

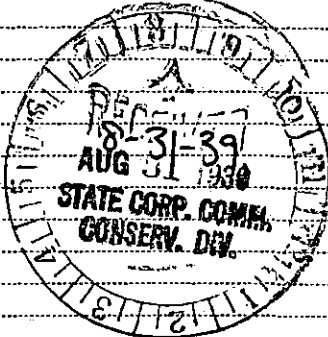

(If additional description is necessary, use BACK of this sheet)

Correspondence regarding this well should be addressed to Kerr-Lynn & Co.
Address 2009 First Natl. Bldg., Okla. City, Okla.

STATE OF OKLAHOMA, COUNTY OF OKLAHOMA, SS.
T. H. Kerr (employee of owner) or (owner or operator) of the above-described well,
being first duly sworn on oath, says: That I have knowledge of the facts, statements, and matters herein contained and the log of the above-described well as filed and that the same are true and correct. So help me God.

KERR - LYNN & CO.
By: [Signature]
2009 First Natl., Okla. City, Oklahoma
(Address)

SUBSCRIBED AND SWORN to before me this 30 day of August, 1939

My commission expires 11-6-40
B.S. Dawson
Notary Public.

Indian Territory Illuminating Oil Co.
 McMoran Number 1
 SE/4 NW/4 Section 25-34S-16W
 Comanche County, Kansas
 Commenced Drilling: June 9, 1939
 Completed Drilling: August 23, 1939

Casing Record:

1060' of 13"OD, cemented w/
 125 sxs

0	40	Red Bed	3843	3910	Shale
40	240	Red bed & shalls	3910	4120	Lime and shale
240	611	Red bed, shale	4120	4169	Lime
611	775	Red bed, shells	4169	4209	Shale
775	796	Broken shells	4209	4267	Lime
796	880	Salt	4267	4297	Hard lime
880	975	Shell	4297	4662	Lime
975	1060	Salt	4662	4683	Hard lime and chert
1060	1086	Red bed	4683	4710	Chert
1080	1130	Green shale	4710	4745	Lime and chert
1130	1562	Red bed, shale	4745	4950	Lime
1562	1827	Shale, shells	4950	5000	Broken lime and shale
1827	1890	Shale, lime shells	5000	5032	Shale and lime
1890	1950	Shale, lime shells (hard)	5032	5057	Chert and shale
1950	2065	Shale & shells	5057	5092	Broken lime, shale
2065	2121	Broken lime	5092	5112	Chert and lime
2121	2208	Shale	5112	5160	Shale
2208	2244	Shale & gyp	5160	5177	Lime
2244	2278	Anhydrate	5177	5205	Lime and shale
2278	2323	Shale & gyp	5205	5235	Lime
2323	2350	Anhydrate	5235	5253	Lime and chert
2350	2375	Shale and shells	5253	5295	Lime and shale
2375	2380	Anhydrate	5295	5351	Lime
2380	2406	Shale	5351	5384	Shale
2406	2456	Shale, shells	5384	5408	Lime
2456	2494	Shale & lime	5408	5422	Shale
2494	2526	Shale and chert	5422	5467	Lime
2526	2576	Broken lime	5467	5540	Viola Lime
2576	2582	Lime	5540	5552	Dolomite and chert
2582	2592	Hard chert	5552	5599	Chert and lime
2592	2600	Shale	5599	5615	Lime
2600	2625	Lime, shells & shale	5615	5646	Sand, lime and chert
2625	2657	Lime	5646	5662	Chert
2657	2690	Lime and chert	5662	5683	Chert & s. dolomite
2690	3016	Lime	5683	5703	Lime
3016	3144	Lime & gyp	5703	5730	Shale
3144	3439	Lime	5730	5748	Sand
3439	3507	Lime and shale	5748	5766	Sand (Cored)
3507	3695	Lime	5766	5781	Lime
3695	3775	Broken lime	5781	5792	Lime (cored)
3775	3843	Shale & lime	5792	5808	Lime

25 34 16
 74 16

10-14-39

I, J. M. Kerr, being first duly sworn on oath, state that I have knowledge of the facts and matter herein set forth and that the same are true and correct according to the drilling reports in this office.

KERR - LYNN & CO.
 By: J. M. Kerr

Subscribed and sworn to before me this 12 day of October, 1939
 My comm. expires: 3-17-41
Wallace W. [Signature] Notary Public