

STATE OF KANSAS
STATE CORPORATION COMMISSION

WELL PLUGGING RECORD

Give All Information Completely
Make Required Affidavit
Mail or Deliver Report to
Conservation Division
State Corporation Comm.
245 North Water
Wichita, KS 67202

Comanche County, Sec. 27 Twp. 34S Rge. 16 NW/4
Location as "NE/CNW 1/4 SW 1/4" or footage from lines

C N 1/2 N 1/2 NW 1/4
Lease Owner Gould Oil, Inc.
Lease Name BEELEY Well No. 1

Office Address 260 N. Rock Rd. Suite 210 Wichita, KS 67206
Character of Well (Completed as Oil, Gas or Dry Hole)

Dry Hole

Date Well completed December 12 1979
Application for plugging filed December 11 1979
Application for plugging approved December 11 1979
Plugging commenced December 12 1979
Plugging completed December 12 1979
Reason for abandonment of well or producing formation


Dry Hole

If a producing well is abandoned, date of last production 19

Was permission obtained from the Conservation Division or its agents before plugging was commenced? Yes

Name of Conservation Agent who supervised plugging of this well Bill Owens
Producing formation Depth to top Bottom Total Depth of Well 5150

Show depth and thickness of all water, oil and gas formations.

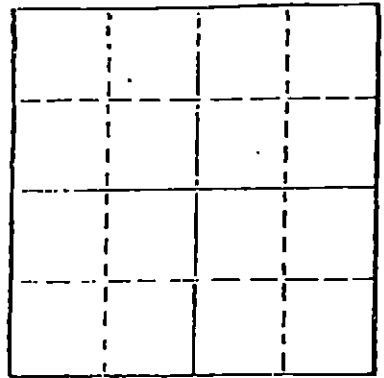

Locate well correctly on above Section Plat

OIL, GAS OR WATER RECORDS

CASING RECORD

FORMATION	CONTENT	FROM	TO	SIZE	PUT IN	PULLED OUT
				8 5/8	609'	

Describe in detail the manner in which the well was plugged, indicating where the mud fluid was placed and the method or methods used in introducing it into the hold. If cement or other plugs were used, state the character of same and depth placed, from feet to feet for each plug set.

50 sacks @ 600
10 sacks @ 40
5 sacks in rathole

RECEIVED
STATE CORPORATION COMMISSION
12-17-79
DEC 17 1979

(If additional description is necessary, use BACK of this sheet)

Name of Plugging Contractor CONSERVATION DIVISION
Wichita, Kansas

STATE OF Kansas COUNTY OF Sedgwick, ss.
Robert L. Eisel (employee of owner) or (owner or operator)

of the above-described well, being first duly sworn on oath, says: That I have knowledge of the facts, statements, and matters herein contained and the log of the above-described well as filed and that the same are true and correct. So help me God.

(Signature) Robert L. Eisel
260 N. Rock Road Suite 210 Wichita, KS 67206
(Address)

SUBSCRIBED AND SWORN TO before me this 13th day of December, 1979

Sharon Winter
Sharon Winter Notary Public.

My commission expires August 13, 1983

SHARON WINTER
STATE NOTARY PUBLIC
SEDGWICK COUNTY, KS.
My Appl. Exp. 08-13-83

