

CARD MUST BE TYPED

State of Kansas
NOTICE OF INTENTION TO DRILL

CARD MUST BE SIGNED

(see rules on reverse side)

Starting Date: May 29 1985
month day year

API Number 15- 033-01004-00-01

OPERATOR: License # 5171
Name TXO Production Corp.
Address 200 W. Douglas, Suite 300
City/State/Zip Wichita, KS 67202
Contact Person Jerry W. Collins
Phone 316-265-9441

. SW . SW . SW . Sec .30. Twp .34. S, Rge 19. East
(location) West

330 Ft North from Southeast Corner of Section
4950 Ft West from Southeast Corner of Section
(Note: Locate well on Section Plat on reverse side)

CONTRACTOR: License # 5106
Name Freeman Drilling Co., Inc.
City/State Wichita, KS 67202

Nearest lease or unit boundary line 330 feet.
County Comanche
Lease Name LEMON "A" Well# 1

Well Drilled For: Well Class: Type Equipment:
 Oil Swd Infield Mud Rotary
 Gas Inj Pool Ext. Air Rotary
 OWWO Expl Wildcat Cable

Domestic well within 330 feet: yes no
Municipal well within one mile: yes no

If OWWO: old well info as follows:

Operator J. M. Huber Corp.
Well Name Lemon-Barbee #1
Comp Date 11-2-53 Old Total Depth 6590'
Projected Total Depth 4400 feet
Projected Formation at TD Toronto
Expected Producing Formations Toronto

Depth to Bottom of fresh water 100 feet
Lowest usable water formation Unknown
Depth to Bottom of usable water 200 feet
Surface pipe by Alternate: 1 2
Surface pipe ~~to be~~ set 495 already set feet
Conductor pipe if any required 0 feet
Ground surface elevation TBD feet MSL
This Authorization Expires 11-23-85
Approved By 5-23-85

I certify that we will comply with K.S.A. 55-101, et seq., plus eventually plugging hole to K.C.C. specifications.

Date 5-22-85 Signature of Operator or Agent Jerry W. Collins

Title Drlg & Completion Engr


Wichita, Kansas
 CONSERVATION DIVISION
 5-23-85
 MAY 23 1985

Must be filed with the K.C.C. five (5) days prior to commencing well
 This card void if drilling not started within six (6) months of date received by K.C.C.

STATE CORPORATION COMMISSION
 A Regular Section of Land
 1 Mile = 5,280 Ft.

Important procedures to follow :

1. Notify District office before setting surface casing.
2. Set surface casing by circulating cement to the top.
3. File completion forms ACO-1 with K.C.C. within 90 days of well completion, following instructions on ACO-1, side 1, and including copies of wireline logs.
4. Notify District office 48 hours prior to old well workover or re-entry.
5. Prior to plugging, prepare a plugging plan, then obtain agreement from the appropriate district office for an approved plugging plan.
6. Submit plugging report (CP-4) to K.C.C. after plugging is completed.
7. Obtain an approved injection docket number before disposing of salt water.
8. Notify K.C.C. within 10 days when injection commences or terminates.
9. If an alternate 2 completion, cement in the production pipe from below any usable water to surface within 120 days of spud date.

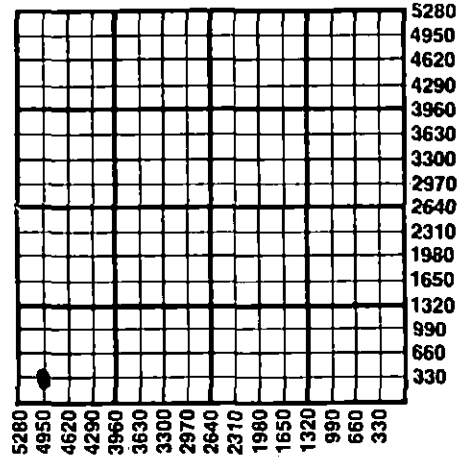

State Corporation Commission of Kansas
 Conservation Division
 200 Colorado Derby Building
 Wichita, Kansas 67202
 (316) 263-3238