

CARD MUST BE TYPED

State of Kansas
NOTICE OF INTENTION TO DRILL
(see rules on reverse side)

CARD MUST BE SIGNED

Starting Date: 11 15 85
month day yearAPI Number 15- 033-20,688-0000OPERATOR: License # 6785
Name Robert Schulein
Address 1776 Lincoln St., #811
City/State/Zip Denver, Colorado 80203
Contact Person Robert Schulein
Phone (303) 839-5495NE SW SW Sec 34 Twp 34 S, Rge 16. East
(location) West..... 990 Ft North from Southeast Corner of Section
4190 Ft West from Southeast Corner of Section
(Note: Locate well on Section Plat on reverse side)CONTRACTOR: License # 5302
Name Red Tiger Drilling Company
City/State Wichita, KansasNearest lease or unit boundary line 330 feet.
County Comanche
Lease Name Murdock Well# 13-34Well Drilled For: Well Class: Type Equipment:
 Oil Swd Infield Mud Rotary
 Gas Inj Pool Ext. Air Rotary
 OWWO Expl Wildcat CableDomestic well within 330 feet: yes no
Municipal well within one mile: yes no

If OWWO: old well info as follows:

Operator
Well Name
Comp Date Old Total Depth
Projected Total Depth 6100 feet
Projected Formation at TD Arbuckle
Expected Producing Formations Viola, Simpson, ArbuckleDepth to Bottom of fresh water 75' feet
Lowest usable water formation White Horse fm.
Depth to Bottom of usable water 200' feet
Surface pipe by Alternate: 1 2
Surface pipe to be set 400 feet
Conductor pipe if any required -0- feet
Ground surface elevation 1859 GR feet MSL
This Authorization Expires 5-1-86

I certify that we will comply with K.S.A. 55-101, et seq., plus eventually plugging hole to K.C.C. specifications.


Date 10-29-85
Signature of Operator or Agent *Robert Schulein*Approved By *[Signature]*

Owner/Operator

Must be filed with the K.C.C. five (5) days prior to commencing well
 This card void if drilling not started within six (6) months of date received by K.C.C.

Important procedures to follow :

**A Regular Section of Land
 1 Mile = 5,280 Ft.**

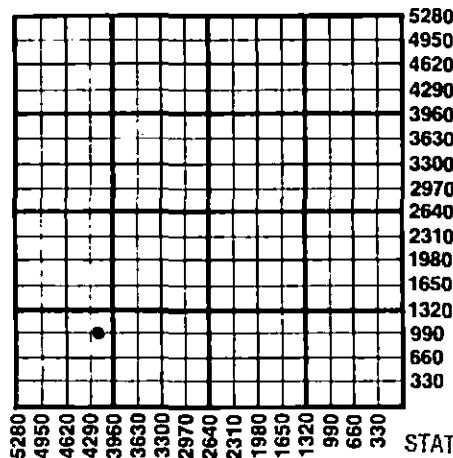

1. Notify District office before setting surface casing.
2. Set surface casing by circulating cement to the top.
3. File completion forms ACO-1 with K.C.C. within 90 days of well completion, following instructions on ACO-1, side 1, and including copies of wireline logs.
4. Notify District office 48 hours prior to old well workover or re-entry.
5. Prior to plugging, prepare a plugging plan, then obtain agreement from the appropriate district office for an approved plugging plan.
6. Submit plugging report (CP-4) to K.C.C. after plugging is completed.
7. Obtain an approved injection docket number before disposing of salt water.
8. Notify K.C.C. within 10 days when injection commences or terminates.
9. If an alternate 2 completion, cement in the production pipe from below any usable water to surface within 120 days of spud date.

RECEIVED

STATE CORPORATION COMMISSION State Corporation Commission of Kansas

Conservation Division

200 Colorado Derby Building

Wichita, Kansas 67202

(316) 263-3238

OCT 31 1985

10-31-85

CONSERVATION DIVISION

Wichita, Kansas