

This form shall be filed in duplicate with the Kansas Corporation Commission, 200 Colorado Derby Building, Wichita, Kansas 67202, within ten days after the completion of the well, regardless of how the well was completed.

Attach separate letter of request if the information is to be held confidential. If confidential, only file one copy. Information on side one will be of public record and side two will then be held confidential.

Circle one: Oil, Gas, Dry, SWD, OWWO, Injection. Type and complete ALL sections. Applications must be filed for dual completion, commingling, SWD and injection.

Attach wireline logs (i.e. electrical log, sonic log, gamma ray neutron log, etc.). KCC # (316) 263-3238. (Rules 82-2-105 & 82-2-125)

OPERATOR R. J. Patrick

API NO. 15-033-20-566 -0000

ADDRESS Box 1314

COUNTY Comanche

Liberal, Kansas

FIELD WILDCAT

\*\*CONTACT PERSON R.J. Patrick

PROD. FORMATION

PHONE 624-8483

LEASE Smith-Weede

PURCHASER NA

WELL NO. # 1

ADDRESS

WELL LOCATION Section 6-34S-19W

DRILLING NRG Drilling, Inc.

1980 Ft. from North Line and

CONTRACTOR

810 Ft. from East Line of

ADDRESS P.O. Box 1157

the SEC. 6 TWP. 34 RGE. 19 (4)

Liberal, Kansas 67901

PLUGGING Halliburton

CONTRACTOR

ADDRESS HWY 54 West


Liberal, Ks 67901

TOTAL DEPTH 5300 PBDT

SPUD DATE 7-6-82 DATE COMPLETED 7/15/82

ELEV: GR 1824' DF KB 1835'

DRILLED WITH (CABLE) (ROTARY) (AIR) TOOLS

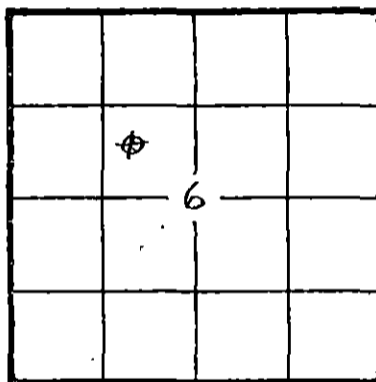

KCC [checked]
KGS [checked]
Office Use

Amount of surface pipe set and cemented 15 jts. of 23# 8 5/8DV Tool Used? No w/ 750 sks

AFFIDAVIT

STATE OF Kansas, COUNTY OF Seward SS, I,

R.J. Patrick OF LAWFUL AGE, BEING FIRST DULY SWORN UPON HIS OATH,

DEPOSES THAT HE IS Owner (FOR)(OF) R.J. Patrick Operating Company

OPERATOR OF THE Smith-Weede LEASE, AND IS DULY AUTHORIZED TO MAKE

THIS AFFIDAVIT FOR AND ON THE BEHALF OF SAID OPERATOR, THAT WELL NO. # 1 ON

SAID LEASE HAS BEEN COMPLETED AS OF THE 15th DAY OF July, 1982, AND THAT

ALL INFORMATION CONTAINED HEREIN WITH RESPECT TO SAID WELL IS TRUE AND CORRECT.


FURTHER AFFIANT SAYS NOT.

SUBSCRIBED AND SWORN TO BEFORE ME THIS 23 DAY OF July, 1982.

(s) R.J. Patrick
Nina F. Patrick
NOTARY PUBLIC

MY COMMISSION EXPIRES JUL 29 1984

\*\*The person who can be reached by phone regarding any questions concerning this information. Within 45 days of completion, a witnessed initial test by the Commission is required if the well produces more than 25 BOPD or is located in a Basic Order Pool.

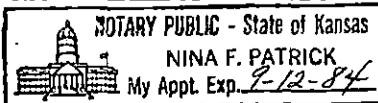

SIDE TWO

WELL LOG

SHOW GEOLOGICAL MARKERS, LOGS RUN, OR OTHER DESCRIPTIVE INFORMATION.

Show all important zones of porosity and contents thereof; cored intervals, and all drill-stem tests, including depth interval tested, cushion used, time tool open, flowing and shut-in pressures, and recoveries.

FORMATION DESCRIPTION, CONTENTS, ETC.	TOP	BOTTOM	NAME	DEPTH
see attachment				

Report of all strings set— surface, intermediate, production, etc. CASING RECORD (New) or (Used)

Purpose of string	Size hole drilled	Size casing set (in O.D.)	Weight lbs/ft.	Setting depth	Type cement	Sacks	Type and percent additives
Conductor	30"	20"		41'	Grout	5yd 10 sks	
Surface	12 1/2"	8 5/8"	23#	606	HOWCO Lite &H	750 sks	CC

LINER RECORD

PERFORATION RECORD

Top, ft.	Bottom, ft.	Sacks cement	Shots per ft.	Size & type	Depth interval

TUBING RECORD		
Size	Setting depth	Packer set at

ACID, FRACTURE, SHOT, CEMENT SQUEEZE RECORD

Amount and kind of material used	Depth interval treated

Date of first production	Producing method (flowing, pumping, gas lift, etc.)	Gravity
RATE OF PRODUCTION PER 24 HOURS	Oil bbls.	Gas bbls.
	Water %	Gas-oil ratio
Disposition of gas (vented, used on lease or sold)	MCF	CFPB
		Perforations

15-033-20566-0000

DRILLER'S LOG

R.J. Patrick Operating Company  
P.O. Box 1314  
Liberal, Kansas 67901

Smith-Weede #1  
Comanche County, Kansas  
Section 6-34S-19W

Surface Casing: Drilled 12 1/4" hole. Ran 15 jnts. of new 23#, 8 5/8" pipe. Set at 606 KB, Cemented the surface hole with 300 sks. of lite 3% CC, 150 sks. of class H, 3%. Float did not hold, 1 inched with 300 sks. of class H, plugged down at 12:45 pm, 7/6/82.

Commenced: July 6, 1982  
Completed: July 15, 1982

Total Depth: 5300'

FORMATION	FROM	TO	REMARKS
Surface Sand	0'	607'	LTD: 5291'
Lime and Shale	607'	5300'	

RECEIVED  
STATE CORPORATION COMMISSION  
JUL 26 1982  
7-26-82  
CONSERVATION DIVISION  
Wichita, Kansas

RECEIVED  
STATE CORPORATION COMMISSION  
JUL 20 1982  
CONSERVATION DIVISION  
Wichita, Kansas

I certify that this is a true and correct copy of the log on the above captioned well to the best of my knowledge.

NRG Drilling, Inc.

By Elmer Jack Taylor  
Elmer Jack Taylor, Vice President

RECEIVED  
STATE CORPORATION COMMISSION  
JUL 29 1982  
CONSERVATION DIVISION  
Wichita, Kansas

Subscribed and sworn to before me \_\_\_\_\_ 19 \_\_\_\_\_ day of \_\_\_\_\_ July \_\_\_\_\_ 19 \_\_\_\_\_ 82



MARNELL PRIBBLE  
Seward County, Kansas  
My Appt. Expires 8-20-83

Marnell Pribble  
Marnell Pribble

My commission expires: 8-20-83