

STATE OF KANSAS
STATE CORPORATION COMMISSION

WELL PLUGGING RECORD

Give All Information Completely
Make Required Affidavit
Mail or Deliver Report to
Conservation Division
State Corporation Comm.
245 North Water
Wichita, KS 67202


Comanche County. Sec. 20 Twp. 34S Rge. 20 SW
Location as "NE/CNW 1/4 SW 1/4" or footage from lines _____

1320' FSL 2310' FEL
Lease Owner Texas Oil & Gas Corp.

Lease Name Schumacher "A" Well No. 1

Office Address 200 W. Douglas, Suite 300, Wichita KS. 67202

Character of Well (Completed as Oil, Gas or Dry Hole) _____
Dry hole

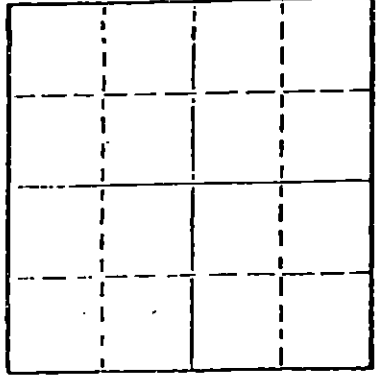

Locate well correctly on above
Section Plot

Date Well completed 2-16-79 19
Application for plugging filed 2-16-79 19
Application for plugging approved 2-16-79 19
Plugging commenced 2-16-79 19
Plugging completed 2-16-79 19
Reason for abandonment of well or producing formation _____

If a producing well is abandoned, date of last production _____ 19

Was permission obtained from the Conservation Division or its agents before plugging was commenced? YES

Name of Conservation Agent who supervised plugging of this well Clarence Thomas

Producing formation _____ Depth to top _____ Bottom _____ Total Depth of Well 5562

Show depth and thickness of all water, oil and gas formations.

OIL, GAS OR WATER RECORDS

CASING RECORD

FORMATION	CONTENT	FROM	TO	SIZE	PUT IN	PULLED OUT
		0	613'	8 5/8"	15 Jts.	NONE

Describe in detail the manner in which the well was plugged, indicating where the mud fluid was placed and the method or methods used in introducing it into the hold. If cement or other plugs were used, state the character of same and depth placed, from _____ feet to _____ feet for each plug set.

@630' 50 sacks cement, @40' 12 sacks, 1/2 sacks hulls,
1 wooden plug, 3 sacks in rat hole. Job completed @
5:30 P. M. 2-16-79.

RECEIVED
STATE CORPORATION COMMISSION
2-22-79
FEB 22 1979
CONSERVATION DIVISION
Wichita, Kansas

(If additional description is necessary, use BACK of this sheet)
Name of Plugging Contractor _____

STATE OF KANSAS COUNTY OF Sedgwick, ss.

Kirby C. Evers (employee of owner) or (owner or operator)
of the above-described well, being first duly sworn on oath, says: That I have knowledge of the facts, statements, and matters herein contained and the log of the above-described well as filed and that the same are true and correct. So help me God.

(Signature) Kirby C. Evers
453 S. Webb Rd., Wichita KS. 67207
(Address)

SUBSCRIBED AND SWORN TO before me this 20 day of February, 19 79

Virginia Lee Smith
Virginia Lee Smith, Notary Public.

My commission expires August 25, 1980



WELL LOG

SCHUMACHER "A" #1
 1320' FSL 2310' FEL
 Section 20-34S-20W
 Comanche County, Kansas

OPERATOR: TEXAS OIL & GAS CORP. COMMENCED: 2-5-79
 CONTRACTOR: XPLOR DRILLING CO. COMPLETED: 2-16-79

CASING RECORD: Ran 15 jts. 8 5/8" casing, new 28#, set @613', cement with 600 sacks cement, 350 sacks Lite Weight, 250 sacks Common. By Service Co.

<u>FORMATION</u>	<u>FROM</u>	<u>TO</u>	<u>ELEVATION</u>
Red Bed and Sand:	0'	2239'	1755 GL
Lime & Shale	2239'	5562'	1760 D.F.
R.T.D.	5562'		1763 K.B.

STATE OF KANSAS)
) SS:
 COUNTY OF SEDGWICK)

I certify that this is a true and correct copy of the Driller's Log of the well drilled 1320' FSL 2310' FEL of Section 20-34S-20W, Comanche County, Kansas, to the best of my knowledge and belief.

XPLOR DRILLING CO.

Kirby C. Evers
 Kirby C. Evers, Vice President

Subscribed and sworn to before me this 20th. day of February, 1979.

MY COMMISSION EXPIRES:
 August 25, 1980

Virginia Lee Smith
 Virginia Lee Smith, Notary Public

