

STATE OF KANSAS  
KANSAS CORPORATION COMMISSION  
CONSERVATION DIVISION  
130 South Market - Room 2078  
Wichita, Kansas 67202

RECEIVED  
STATE CORPORATION COMMISSION

SEP 07 2000

FORM CP-1 (3/92)  
CONSERVATION DIVISION  
Wichita, Kansas

WELL PLUGGING APPLICATION FORM  
(PLEASE TYPE FORM and File ONE Copy)

API # 15-007-21, 015 <sup>00.00</sup> (Identifier number of this well). This must be listed for wells drilled since 1967; if no API# was issued, indicate spud or completion date.

WELL OPERATOR Woolsey Petroleum Corp. KCC LICENSE # 5506 <sup>6/01</sup>  
(owner/company name) (operator's)  
ADDRESS 1966 SE Rodeo Drive Rd. CITY Medicine Lodge

STATE KS ZIP CODE 67104 CONTACT PHONE # (316) 886-5606

LEASE Hull WELL# E-1 SEC. 35 T. 32 R. 14 (East/West)

E<sub>1/2</sub> - W<sub>1/2</sub> - SW SPOT LOCATION/QQQQ COUNTY Barber

1320 FEET (in exact footage) FROM (S) (circle one) LINE OF SECTION (NOT Lease Line)

990 FEET (in exact footage) FROM E (circle one) LINE OF SECTION (NOT Lease Line)

Check One: OIL WELL  GAS WELL  D&A  SWD/ENHR WELL  DOCKET# \_\_\_\_\_

CONDUCTOR CASING SIZE \_\_\_\_\_ SET AT \_\_\_\_\_ CEMENTED WITH \_\_\_\_\_ SACKS

SURFACE CASING SIZE 8 5/8" SET AT 412' CEMENTED WITH 400 SACKS

PRODUCTION CASING SIZE 2 7/8" SET AT 4750' CEMENTED WITH 150 SACKS

LIST (ALL) PERFORATIONS and BRIDGEPLUG SETS: see attachment

ELEVATION 1972' T.D. 4783' PBSD \_\_\_\_\_ ANHYDRITE DEPTH 1625'  
(G.L./K.B.) (Stone Corral Formation)

CONDITION OF WELL: GOOD  POOR  CASING LEAK  JUNK IN HOLE

PROPOSED METHOD OF PLUGGING Cut csg @ free point. Pump 25 sx cement. Pull csg to 600'  
and pump 50 sx. Pull csg to 442' and pump 50 sx. Pull csg to 30' and pump cement to  
surface.

(If additional space is needed attach separate page)

IS WELL LOG ATTACHED TO THIS APPLICATION AS REQUIRED?  IS ACO-1 FILED?

If not explain why? \_\_\_\_\_

PLUGGING OF THIS WELL WILL BE DONE IN ACCORDANCE WITH K.S.A. 55-101 et. seq. AND THE RULES AND REGULATIONS OF THE STATE CORPORATION COMMISSION.

LIST NAME OF COMPANY REPRESENTATIVE AUTHORIZED TO BE IN CHARGE OF PLUGGING OPERATIONS:

Carl W. Durr PHONE# (316) 886-5606 Ext. 27

ADDRESS 1966 SE Rodeo Drive Rd. City/State Medicine Lodge, KS 67104

PLUGGING CONTRACTOR Pratt Well Service KCC LICENSE # 5893 <sup>6/01</sup>  
(company name) (contractor's)

ADDRESS Box 847, Pratt, KS 67124 PHONE # (316) 672-2531

PROPOSED DATE AND HOUR OF PLUGGING (If Known?) \_\_\_\_\_

PAYMENT OF THE PLUGGING FEE (K.A.R. 82-3-118) WILL BE GUARANTEED BY OPERATOR OR AGENT

DATE: 9/6/00 AUTHORIZED OPERATOR/AGENT: Carl W. Durr  
(signature)

de

# WELL COMPLETION SHEET

## WELLBORE DIAGRAM

LEASE NAME & #: Hull # E-1

DATE: 8/29/00

SEC. 35 T 32 R 14W

CSG SIZE: 2 7/8"

TYPE OF WELL-HEAD \_\_\_\_\_

TBG SIZE: \_\_\_\_\_

SUPERVISOR: \_\_\_\_\_

TOTAL TBG: \_\_\_\_\_

DEPTH OF TBG: \_\_\_\_\_

# OF JTS: \_\_\_\_\_

TBG SUBS: \_\_\_\_\_

PUMP SIZE: \_\_\_\_\_

PUMP #: \_\_\_\_\_

# OF RODS: \_\_\_\_\_

PONY RODS: \_\_\_\_\_

ZERO: \_\_\_\_\_

PU BRAND: \_\_\_\_\_

SIZE: \_\_\_\_\_ SERIAL #: \_\_\_\_\_

SPM: \_\_\_\_\_ SHEAVE SIZE: \_\_\_\_\_

BELT SIZE & LENGTH: \_\_\_\_\_

STROKE LENGTH: \_\_\_\_\_

ENGINE BRAND & SIZE: \_\_\_\_\_

SHEAVE SIZE: \_\_\_\_\_ RPM: \_\_\_\_\_

SERIAL #: \_\_\_\_\_

H/T BRAND: \_\_\_\_\_

WTR TNK SIZE: \_\_\_\_\_


NET: \_\_\_\_\_ CLOSED TOP: \_\_\_\_\_

STOCK TNK: \_\_\_\_\_ SERIAL #: \_\_\_\_\_

SEPARATOR BRAND: \_\_\_\_\_

SIZE: \_\_\_\_\_ WP: \_\_\_\_\_ PH: \_\_\_\_\_

REMARKS: \_\_\_\_\_

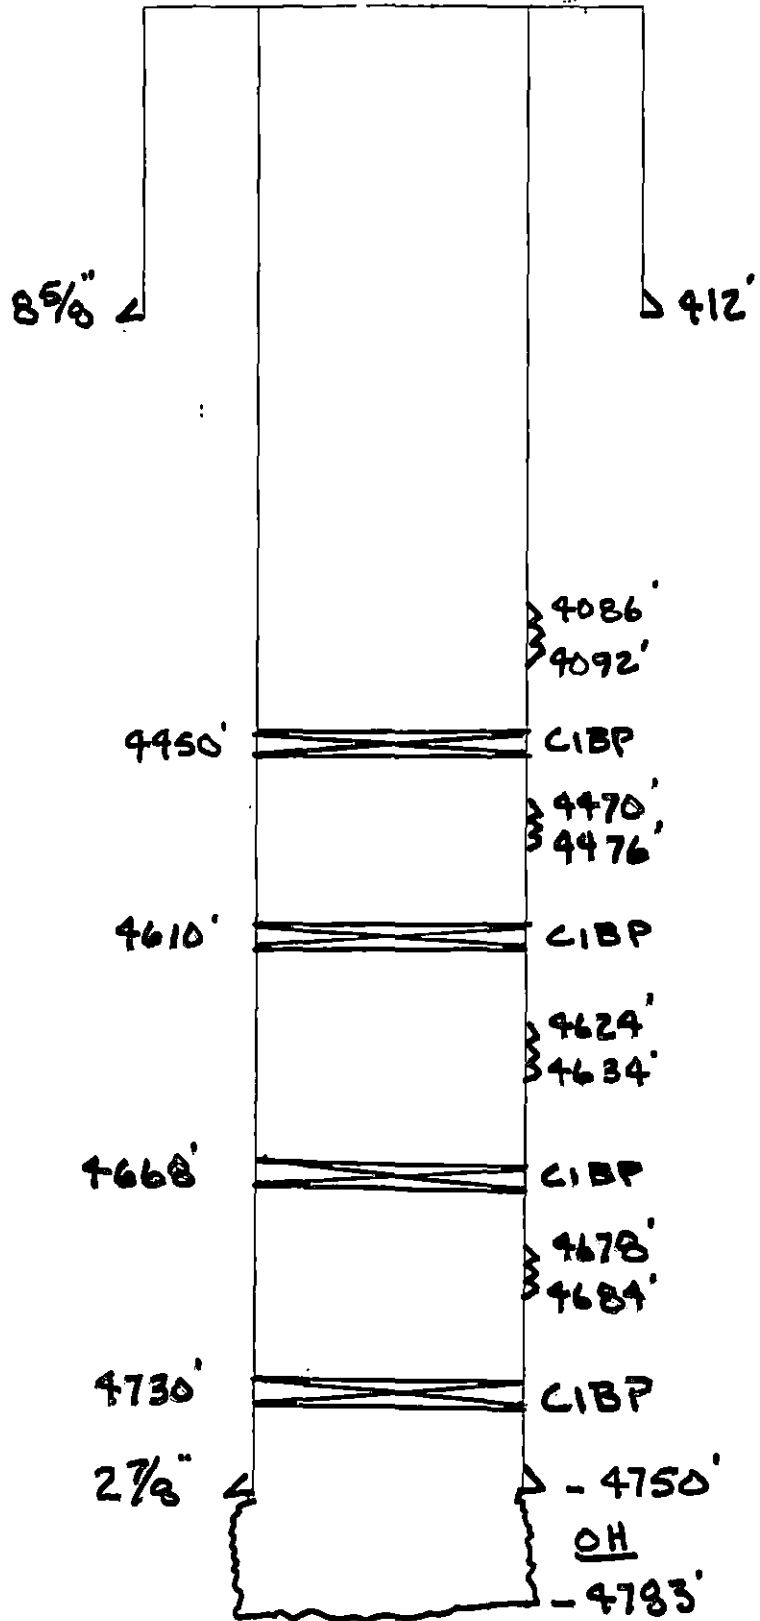

RECEIVED  
STATE CORPORATION COMMISSION

SEP 07 2001

CONSERVATION DIVISION  
Wichita, Kansas



## Kansas Corporation Commission

Bill Graves, Governor   John Wine, Chair   Cynthia L. Claus, Commissioner   Brian J. Moline, Commissioner

### NOTICE OF RECEIPT OF WELL PLUGGING APPLICATION (CP-1)

Woolsey Petroleum Corporation  
125 N. Market, Suite 1000  
Wichita, KS 67202-1775

September 12, 2000

HULL - E #1  
API 15-007-21015-00-00  
1320 S 990 W  
CE2W2SW 35-32S-14W  
BARBER COUNTY

Dear Carl W. Durr:

This letter is to notify you that the Conservation Division is in receipt of your plugging proposal, form CP-1, for the above-captioned well.

Your CP-1 has been reviewed by the Conservation Division central office for completeness and to verify license numbers. The plugging proposal will now be forwarded to the district office listed below for review of your proposed method of plugging.

**Please contact the district office for approval of your proposed plugging method at least five (5) days before plugging the well, pursuant to K.A.R. 82-3-113 (b). If a workover pit will be used during the plugging of the well it must be permitted. A CDP-1 form must be filed and approved prior to the use of the pit.**

The Conservation Division's review of form CP-1, either in the central or district office, does not include an inquiry into well ownership or the filing operator's legal right to plug the well.

**This notice in no way constitutes authorization to plug the above-captioned well by persons not having legal rights of ownership or interest in the well. This notice is void after ninety (90) days from the above date.**

District: #1  
304 W. McArtor  
Dodge City, KS 67801  
(316) 225-8888

Sincerely,

A handwritten signature in cursive script, appearing to read "David P. Williams".

David P. Williams  
Production Supervisor