

STATE OF KANSAS
STATE CORPORATION COMMISSION
CONSERVATION DIVISION
200 Colorado Derby Building
Wichita, Kansas 67202

FORM CP-1
Rev. 03/92

JUN 27 2000

WELL PLUGGING APPLICATION FORM
(PLEASE TYPE FORM and File ONE Copy)

API # 15-007-22,382-00 (Identifier number of this well). This must be listed for wells drilled since 1967; if no API# was issued, indicate spud or completion date.

WELL OPERATOR Pickrell Drilling Company, Inc. KCC LICENSE # 5123
(owner/company name) (operator's)

ADDRESS 100 S. Main, Suite 505 CITY Wichita

STATE Kansas ZIP CODE 67202 CONTACT PHONE # (316) 262-8427

LEASE Cargill "G" WELL# 1 SEC. 27 T. 30S R. 12 (East West)

-SE - SE - NW SPOT LOCATION/QQQQ COUNTY Barber

2310 FEET (in exact footage) FROM S/N (circle one) LINE OF SECTION (NOT Lease Line)

2310 FEET (in exact footage) FROM E/W (circle one) LINE OF SECTION (NOT Lease Line)

Check One: OIL WELL GAS WELL D&A SWD/ENHR WELL DOCKET#

CONDUCTOR CASING SIZE SET AT CEMENTED WITH SACKS

SURFACE CASING SIZE 8 5/8 SET AT 233 CEMENTED WITH 170 SACKS

PRODUCTION CASING SIZE 4 1/2 SET AT 4685 CEMENTED WITH 275 SACKS

LIST (ALL) PERFORATIONS and BRIDGEPLUG SETS: See well sketch attached

ELEVATION 1781 KB T.D. 4706 1/2 PBDT 4428 ANHYDRITE DEPTH Heebner 3628 (1847)
(G.L./K.B.) (Stone Corral Formation)

CONDITION OF WELL: GOOD POOR CASING LEAK JUNK IN HOLE

PROPOSED METHOD OF PLUGGING Plug back w/ sand to 3975 ft. Use dump bailer to spot 5 sx.

of cement on top of sand. Shoot off pipe and start out of hole. Through casing spot 50

sx. at 800 ft. Spot 40 sx. at 275 ft. Spot 10 sx. at 40 ft. Check annulus as requested by

(If additional space is needed attach separate page)

KCC representative. Use 60/40 Poz cement w/ 6% gel for plugs.
IS WELL LOG ATTACHED TO THIS APPLICATION AS REQUIRED? Yes IS ACO-1 FILED? Yes

If not explain why? _____

RECEIVED
STATE CORPORATION COMMISSION

PLUGGING OF THIS WELL WILL BE DONE IN ACCORDANCE WITH K.S.A. 55-101 et. seq. AND THE RULES AND REGULATIONS OF THE STATE CORPORATION COMMISSION.

JUN 29 2000

LIST NAME OF COMPANY REPRESENTATIVE AUTHORIZED TO BE IN CHARGE OF PLUGGING OPERATIONS:

CONSERVATION DIVISION
Wichita, Kansas

Ron Smith PHONE# (316) 793-2316

ADDRESS 2485 S. State Road 14 City/State Kingman, KS 67068-8629

PLUGGING CONTRACTOR Clark Corporation KCC LICENSE # 5105
(company name) (contractor's)

ADDRESS 107 W. Fowler, P.O. Box 187, Medicine Lodge PHONE # (316) 886-5665
KS 67104-0187

PROPOSED DATE AND HOUR OF PLUGGING (If known?) July 5, 2000

PAYMENT OF THE PLUGGING FEE (K.A.R. 82-3-118) WILL BE GUARANTEED BY OPERATOR OR AGENT

DATE: 6-26-00 AUTHORIZED OPERATOR/AGENT: Jack Gurley
(signature)


Jack Gurley

SE

BAKER SERVICE TOOLS - TALLY PAD

New Completion Workover

Oil Company _____ Well No. 1 Field _____ Lease Cargill "G"
 Company Man _____ Date Drilled 11/91 County Barber State Kansas

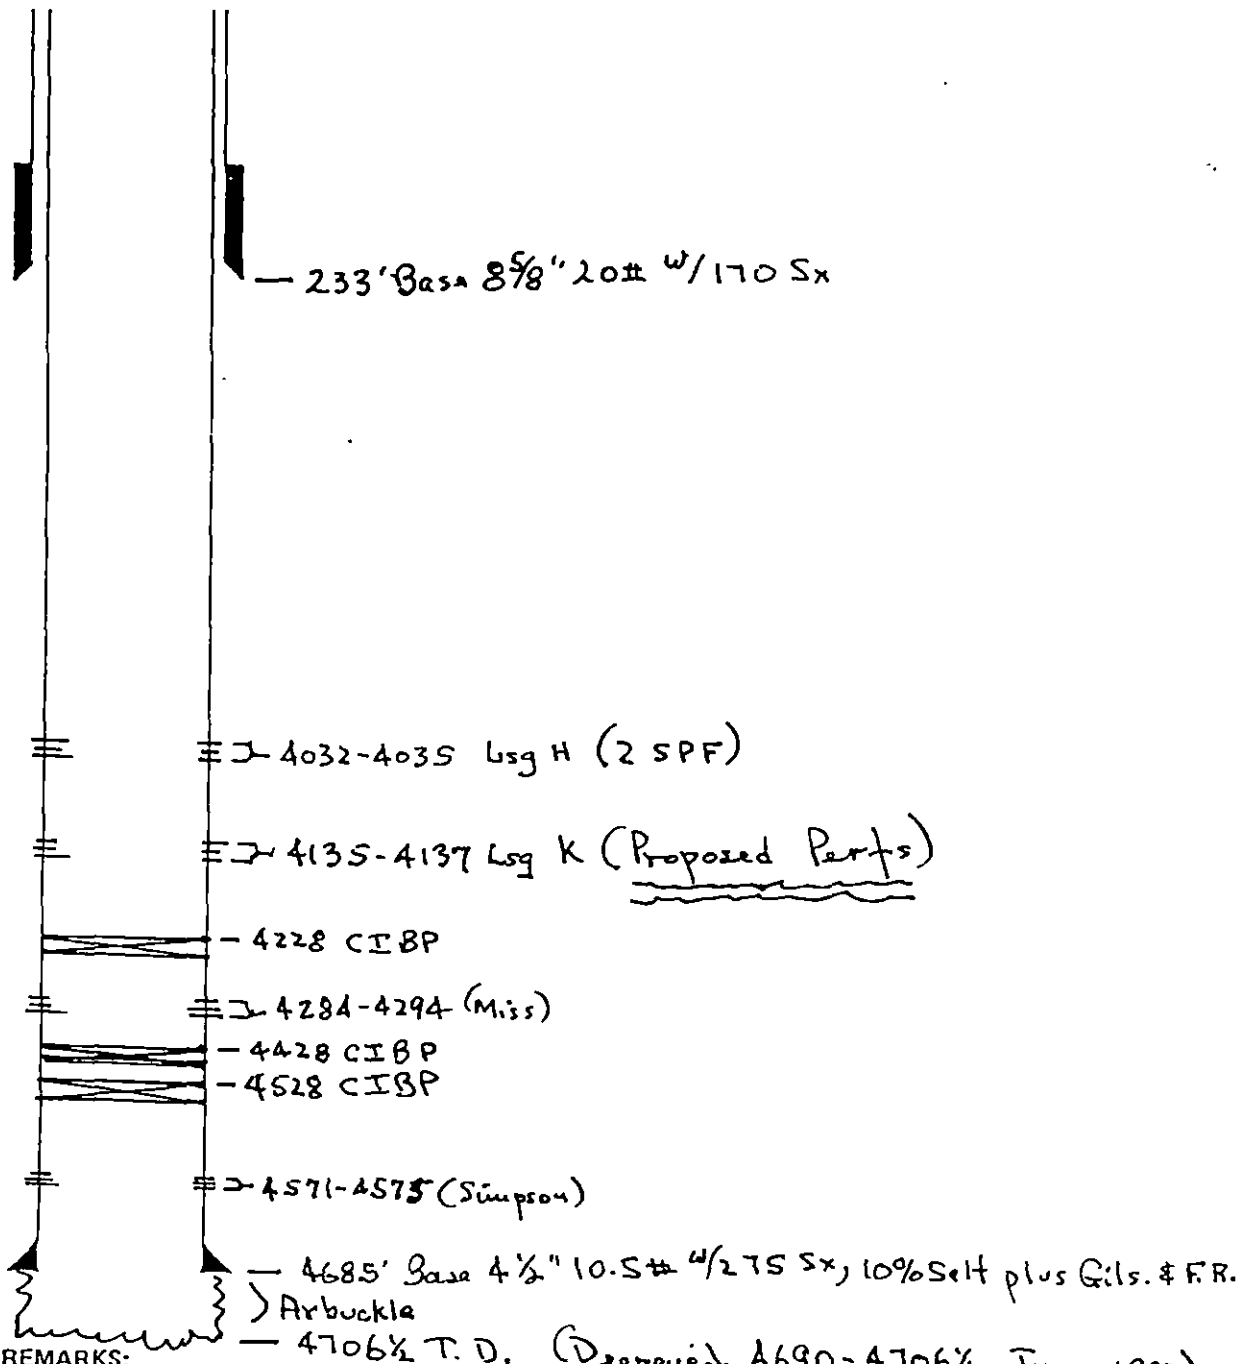

REMARKS: _____

- 1) Produced Arb. 4685-4690
- 2) Deepened Arb. 4690-4706 1/2
- 3) Saved Arb (Cum prod = 2965 Bbls)
- 4) Test Simpson
- 5) Test Miss
- 6) Recomp. in Lsg H (Cum prod 148 MMCF, 2/00)

RECEIVED
 STATE CORPORATION COMMISSION
 JUN 29 2000
 CONSERVATION DIVISION
 Wichita, Kansas



Kansas Corporation Commission

Bill Graves, Governor John Wine, Chair Cynthia L. Claus, Commissioner Brian J. Moline, Commissioner

NOTICE OF RECEIPT OF WELL PLUGGING APPLICATION (CP-1)

Pickrell Drilling Company, Inc.
100 South Main - Suite 505
Wichita, KS 67202-3738

July 14, 2000

CARGILL G #1
API 15-007-22382-00-00
2310 N 2310 W
SE SE NW 27-30S-12W
BARBER COUNTY

Dear Ron Smith:

This letter is to notify you that the Conservation Division is in receipt of your plugging proposal, form CP-1, for the above-captioned well.

Your CP-1 has been reviewed by the Conservation Division central office for completeness and to verify license numbers. The plugging proposal will now be forwarded to the district office listed below for review of your proposed method of plugging.

Please contact the district office for approval of your proposed plugging method at least five (5) days before plugging the well, pursuant to K.A.R. 82-3-113 (b). If a workover pit will be used during the plugging of the well it must be permitted. A CDP-1 form must be filed and approved prior to the use of the pit.

The Conservation Division's review of form CP-1, either in the central or district office, does not include an inquiry into well ownership or the filing operator's legal right to plug the well.

This notice in no way constitutes authorization to plug the above-captioned well by persons not having legal rights of ownership or interest in the well. This notice is void after ninety (90) days from the above date.

Sincerely,

A handwritten signature in cursive script, appearing to read "David P. Williams".

David P. Williams
Production Supervisor

District: #1
304 W. McArtor
Dodge City, KS 67801
(316) 225-8888