


STATE OF KANSAS
STATE CORPORATION COMMISSION

WELL PLUGGING RECORD

Give All Information Completely
Make Required Affidavit
Mail or Deliver Report to
Conservation Division
State Corporation Comm.
245 North Water
Wichita, KS 67202

Comanche County, Sec. 1 Twp. 34S Rge. 20 NW/W
Location as "NE/CNW $\frac{1}{4}$ SW $\frac{1}{4}$ " or footage from lines
C-NW of SW
Lease Owner R.J. Patrick Operating Company
Lease Name WESLEY GIRK Well No. 1
Office Address P.O. Box 1314, Liberal, KS 67901
Character of Well (Completed as Oil, Gas or Dry Hole)

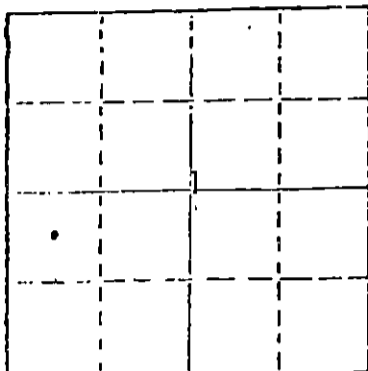

Locate well correctly on above
Section Plot

DRY HOLE
Date Well completed January 5, 1981
Application for plugging filed January 6, 1981
Application for plugging approved 19
Plugging commenced January 5, 1981
Plugging completed January 5, 1981
Reason for abandonment of well or producing formation

DRY HOLE
If a producing well is abandoned, date of last production
19

Was permission obtained from the Conservation Division or
its agents before plugging was commenced? Yes

Name of Conservation Agent who supervised plugging of this well Wm. T. Owen, Pratt, KS
Producing formation - Depth to top - Bottom - Total Depth of Well 4806'
Show depth and thickness of all water, oil and gas formations.

OIL, GAS OR WATER RECORDS

20" 59'

CASING RECORD

FORMATION	CONTENT	FROM	TO	SIZE	PUT IN	PULLED OUT
				20"	59'	Conductor Pipe-
				8-5/8"	636'	NONE

Describe in detail the manner in which the well was plugged, indicating where the mud fluid
was placed and the method or methods used in introducing it into the hold. If cement or other
plugs were used, state the character of same and depth placed, from _____ feet to
_____ feet for each plug set.

60 sack Plug at 420',
10 sack Plug at 40',
10 sack Plug in Mousehole
Job complete at 11:45 PM 1/5/81

(If additional description is necessary, use BACK of this sheet)

Name of Plugging Contractor Halliburton

1-9-81
CONSERVATION DIVISION
Wichita, Kansas ss.

STATE OF Kansas COUNTY OF Seward
R.J. Patrick (employee of owner) or (owner or operator)


of the above-described well, being first duly sworn on oath, says: That I have knowledge of
the facts, statements, and matters herein contained and the log of the above-described well
as filed and that the same are true and correct. So help me God.

(Signature)

R.J. Patrick

P.O. Box 1314, Liberal, KS 67901
(Address)

SUBSCRIBED AND SWORN TO before me this 6th day of January, 1981

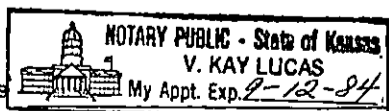

V. Kay Lucas

Notary Public.

My commission expires