

STATE OF KANSAS
STATE CORPORATION COMMISSION

WELL PLUGGING RECORD

Give All Information Completely
Make Required Affidavit
Mail or Deliver Report to
Conservation Division
State Corporation Comm.
245 North Water
Wichita, KS 67202

Comanche County, Sec. 2 Twp. 34 Rge. 20 ~~XX~~/W
Location as "NE/CNW $\frac{1}{4}$ /SW $\frac{1}{4}$ " or footage from lines
NE of NE

Lease Owner R.J. Patrick Operating Company
Lease Name Ora Baker Well No. 4


Office Address P.O. Box 1314 Liberal, Kansas 67901
Character of Well (Completed as Oil, Gas or Dry Hole)
Dry Hole

Date Well completed March 21, 1982 19
Application for plugging filed March 21, 1982 19
Application for plugging approved 19
Plugging commenced March 21, 1982 19
Plugging completed March 21, 1982 19
Reason for abandonment of well or producing formation

If a producing well is abandoned, date of last production
N/A 19

Was permission obtained from the Conservation Division or
its agents before plugging was commenced? yes

Name of Conservation Agent who supervised plugging of this well Paul Luthi
Producing formation --- Depth to top -- Bottom --- Total Depth of Well 4830'
Show depth and thickness of all water, oil and gas formations.

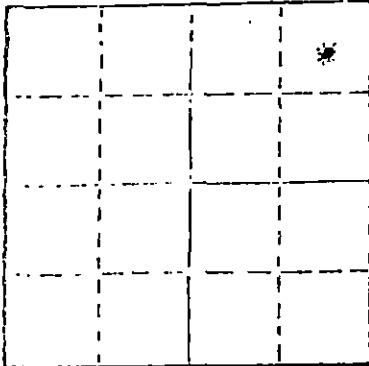

Locate well correctly on above
Section Plot

OIL, GAS OR WATER RECORDS

CASING RECORD

FORMATION	CONTENT	FROM	TO	SIZE	PUT IN	PULLED OUT
		Conductor Pipe		50'	30"	none
		Surface CSG		8 5/8"	644.18'	none

Describe in detail the manner in which the well was plugged, indicating where the mud fluid was placed and the method or methods used in introducing it into the hold. If cement or other plugs were used, state the character of same and depth placed, from feet to feet for each plug set.

Plugged with 120 sks. total of Class H Cement,
1st plug, 60 sks. @ 1180'
2nd plug, 35 sks. @ 620'
3rd plug, 10 sks. @ 0-40'
4th plug, 5 sks. @ Mouse hole
5th plug, 10 sks. @ Rat hole
Plug down @ 3:pm 3/21/82


RECEIVED
STATE CORPORATION COMMISSION
MAR 25 1982
3-25-82
CONSERVATION DIVISION
Wichita Kansas

(If additional description is necessary, use BACK of this sheet)

Name of Plugging Contractor

STATE OF Kansas COUNTY OF Seward, ss.
Elmer Jack Taylor (employee of owner) or ~~(owner or operator)~~

of the above-described well, being first duly sworn on oath, says: That I have knowledge of the facts, statements, and matters herein contained and the log of the above-described well as filed and that the same are true and correct. So help me God.

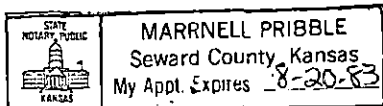

(Signature) Elmer Jack Taylor
P.O. Box 1157 Liberal, Kansas 67901
(Address)

SUBSCRIBED AND SWORN TO before me this 22 day of March, 1982

Marnell Pribble
Marnell Pribble Notary Public.

My commission expires 8-20-83

DRILLER'S LOG

R.J. Patrick Operating Company
 P.O. Box 1314
 Liberal, Kansas 67901

Ora Baker #4
 NE of NE of Section 2-34S-20W
 Comanche County, Kansas

Total Depth: 4830'

Surface Casing: Drilled 837' of 12½" hole.
 Ran 16 jnts. of 8 5/8" new 23# pipe, total
 644.18 set @ 642 K.B., cemented with 200 sks
 of lite W/2% CC, tailed w/150 sks class H, 3%
 CC, plugged down @ 6:am 3/10/82. 1" w/300 sks
 class H, 3% CC, spuded on 3/9/82 @ 3:pm.

Commenced: 3/9/82
 Completed: 3/21/82

Rotary Total Depth: 4830'
 Loggers Total Depth: 4828'

FORMATION	FROM	TO	REMARKS
Surface sand & Red Bed	0'	1190'	
Lime & Shale	1190'	4830'	

RECEIVED
 STATE CORPORATION COMMISSION
 MAR 25 1982
 3-25-82
 CONSERVATION DIVISION
 Wichita Kansas

I certify that this is a true and correct copy of the log on the above captioned well to the best of my knowledge.

NRG Drilling, Inc.

By Elmer Jack Taylor
 Elmer Jack Taylor, Vice-President

Subscribed and sworn to before me this 22 day of March 19 82

STATE NOTARY PUBLIC
 MARNELL PRIBBLE
 Seward County, Kansas
 My Appt. Expires 8-20-83

Marnell Pribble
 Marnell Pribble

My commission expires: 8-20-83