


STATE OF KANSAS
STATE CORPORATION COMMISSION

WELL PLUGGING RECORD

Give All Information Completely
Make Required Affidavit
Mail or Deliver Report to
Conservation Division
State Corporation Comm.
245 North Water
Wichita, KS 67202

Comanche County, Sec. 2 Twp. 34S Rge. 20W E/W
Location as "NE/CNW $\frac{1}{4}$ SW $\frac{1}{4}$ " or footage from lines
Approx. 660' from nearest lease line
Lease Owner KRM Petroleum Corporation
Lease Name Selzer Well No. 1-2
Office Address Guaranty Bk. Bldg, 817 Seventeenth St.
Denver, Colorado 80202
Character of Well (Completed as Oil, Gas or Dry Hole)

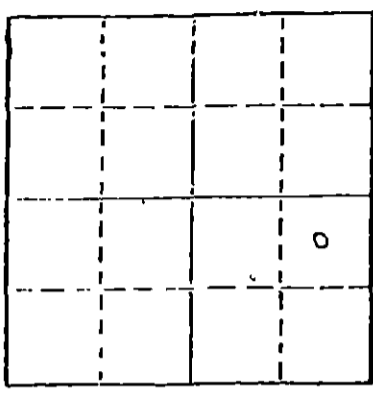

Locate well correctly on above
Section Plot

Date Well completed 2-14 19 81
Application for plugging filed 2-14 19 81
Application for plugging approved 2-14 19 81
Plugging commenced 2-14 19 81
Plugging completed 2-14 19 81

Reason for abandonment of well or producing formation
Dry Hole
If a producing well is abandoned, date of last production 19

Was permission obtained from the Conservation Division or
its agents before plugging was commenced? Yes

Name of Conservation Agent who supervised plugging of this well M. B. Lesley
Producing formation _____ Depth to top _____ Bottom _____ Total Depth of Well _____
Show depth and thickness of all water, oil and gas formations.

OIL, GAS OR WATER RECORDS

CASING RECORD

FORMATION	CONTENT	FROM	TO	SIZE	PUT IN	PULLED OUT
		0	698	8 5/8"	16 jnts	

Describe in detail the manner in which the well was plugged, indicating where the mud fluid
was placed and the method or methods used in introducing it into the hold. If cement or other
plugs were used, state the character of same and depth placed, from _____ feet to
_____ feet for each plug-set.

Set 50 sacks common cement plug at 690', 10 sack common at 40 fts with plug.,
10 sack common in rat hole, 5 sacks common in mouse hole. Completed at
3:45 PM on February 14, 1981.

RECEIVED
FEB 19 1981
2-19-81
CONSERVATION DIVISION
Wichita, Kansas

(If additional description is necessary, use BACK of this sheet)


Name of Plugging Contractor Halliburton

STATE OF Kansas COUNTY OF Sedgwick, ss.
Kirby C. Evers, Vice President (employee of owner) or (owner or operator)
of the above-described well, being first duly sworn on oath, says: That I have knowledge of
the facts, statements, and matters herein contained and the log of the above-described well
as filed and that the same are true and correct. So help me God.

(Signature) Kirby C. Evers
P. O. Box 18611, Wichita, Kansas 67207
(Address)

SUBSCRIBED AND SWORN TO before me this 17th day of February, 19 81

My commission expires Nov. 28, 1984
Mary Kay Oeding
Notary Public.

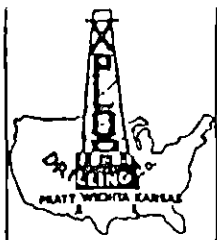

15-033-20399-0000
 453 SOUTH WEBB ROAD
 P. O. BOX 18611
 WICHITA, KANSAS 67207
 (316) 685-5372

**XPLOR
 DRILLING CO.**

WELL LOG

OPERATOR: KRM Petroleum Corporation
 CONTRACTOR: Xplor Drilling Co., Inc.

COMMENCED: February 3, 1981
 COMPLETED: February 14, 1981

CASING RECORD: 715' - 8 5/8 casg.

=====

<u>FORMATION</u>	<u>FROM</u>	<u>TO</u>
Red Bed	0	1912
Anly & Dolo	1912	2244
Anhy - Dolo - Shale	2244	2406
Lime & Shale	2406	3083
Slime & Shale & Dolo	3083	3145
Lime & Shale	3145	5172
Lime	5172	5272
Mississippi	5272	

RECEIVED
 STATE COMMISSION

FEB 19 1981
 2-19-81
 CONSERVATION DIVISION
 Wichita, Kansas

STATE OF KANSAS)
) SS:
 COUNTY OF SEDGWICK)

I CERTIFY THAT THIS IS A TRUE AND CORRECT COPY OF THE DRILLER'S LOG ON THE WELL DRILLED NE SE Sec. 2-34S-20W, Comanche County Kansas TO THE BEST OF MY KNOWLEDGE AND BELIEF.

XPLOR DRILLING CO., INC.
Kirby C. Evers
 Kirby C. Evers, Vice President

Subscribed and sworn to before me this 17th day of February 1981.
 My Appointment expires Nov. 28, 1984
Mary Kay Oeding