

15-033-20531-0000

STATE OF KANSAS
STATE CORPORATION COMMISSION
CONSERVATION DIVISION
P. O. BOX 17027
WICHITA, KANSAS 67217

WELL PLUGGING RECORD

Comanche County, Sec. 12 Twp. 34S Rge. 20 (E) (W) X
Location as "NE/CNW/SE/SW" or footage from lines. 1930' FEL-1980' FNL

Lease Owner Nortex Gas and Oil

Lease Name Petro 12 Well No. #1

Office Address Box 36288, Tulsa, OK 74135

Character of Well (completed as Oil, Gas or Dry Hole) Dry Hole

Date well completed February 12 19 82

Application for plugging filed February 12 19 82

Application for plugging approved February 12 19 82


Plugging commenced February 13 19 82

Plugging completed February 13 19 82

Reason for abandonment of well or producing formation Dry Hole

If a producing well is abandoned, date of last production 19

Was permission obtained from the Conservation Division or its agents before plugging was commenced? yes

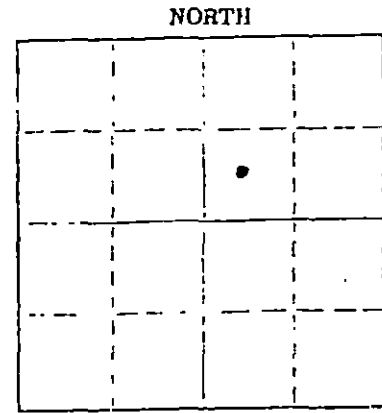

Locate well correctly on above Section Plat

Name of Conservation Agent who supervised plugging of this well Paul Luthi

Producing formation X Depth to top X Bottom X Total Depth of Well 5500 Feet

Show depth and thickness of all water, oil and gas formations.

OIL, GAS OR WATER RECORDS

CASING RECORD

FORMATION	CONTENT	FROM	TO	SIZE	PUT IN	PULLED OUT
				20"	45'	None
				8 5/8"	606	None

Describe in detail the manner in which the well was plugged, indicating where the mud fluid was placed and the method or methods used in introducing it into the hole. If cement or other plugs were used, state the character of same and depth placed, from _____ feet to _____ feet for each plug set.

60 Vis Mud Tld to Surface

50 sx- (4750'-4650')

35 sx- (580'- 510')

10 sx- (40' to surface)

10 sx- (Rathole)

Weld plat with number and date

RECEIVED
STATE CORPORATION COMMISSION

MAR 5 1982
3-5-82
CONSERVATION DIVISION
Wichita, Kansas

(If additional description is necessary, use BACK of this sheet)
Name of Plugging Contractor Zenith Drilling Co.

Address Liberal, KS

STATE OF Oklahoma COUNTY OF Woodward ss.

Robert W. Ward (employee of owner) or (owner or operator) of the above-described well, being first duly sworn on oath, says: That I have knowledge of the facts, statements, and matters herein contained and the log of the above-described well as filed and that the same are true and correct. So help me God.

(Signature) Robert W. Ward

Box 249, Woodward, OK 73801
(Address)

Subscribed and sworn to before me this 15th day of February 19 82

My commission expires 4-24-85

Sandy Juissler
Notary Public.

WELL LOG

COMPANY InterNorth, Inc.

SEC. 12-34-20W

FARM Petro

NO. 12-1

LOC. 150' W of SW NE


TOTAL DEPTH 5500

COUNTY Comanche, KS.

COMM. 1-28-82

COMP. 2-09-82

CONTRACTOR Zenith Drilling Corporation

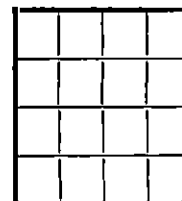

Ran 14 ^{CASING} jts., 28#, X42, 8 5/8" csg., set at 606' with 475 sacks cement

ELEVATION

PRODUCTION

FIGURES INDICATE BOTTOM OF FORMATIONS

305	Sand & Red Bed
606	Red Bed & Lime
5500	Lime & Shale

PLUGGING INFORMATION

50 SACKS CEMENT AT 4750'
 35 SACKS CEMENT AT 580'
 10 SACKS CEMENT AT 40'
 5 Sacks in Mouse Hole
 5 Sacks in Rat Hole

Job complete 11:45 A.M. 2-13-82

RECEIVED
STATE CORPORATION COMMISSION

MAR 5 1982
3-5-82
CONSERVATION DIVISION
Wichita, Kansas

State of KANSAS }
County of SEDGWICK } ss

I, Emmet E. Hall of Zenith Drilling Corporation

upon oath state the above and foregoing is a true and correct copy of the log of the Petro 12-1 well.

Subscribed and sworn to before me this 16th day of February, 1982.

My Commission Expires: December 15, 1984

Sharon R. Allen
Sharon R. Allen NOTARY PUBLIC