

15-033-20168-0000


STATE OF KANSAS  
STATE CORPORATION COMMISSION

Form CP-4

Give All Information Completely  
Make Required Affidavit  
Mail or Deliver Report to:  
Conservation Division  
State Corporation Commission  
P. O. Box 17027  
Wichita, Kansas 67217  
NORTH

WELL PLUGGING RECORD

COMANCHE County. Sec. 5 Twp. 34S Rge. 20W (E) (W)  
Location as "NE/CNW/SW" or footage from lines C SE/4  
Lease Owner PICKRELL DRILLING COMPANY  
Lease Name BUTTS "B" Well No 1  
Office Address 705 FOURTH NAT'L BANK BLDG. WICHITA, KS. 67202  
Character of Well (completed as Oil, Gas or Dry Hole) Dry Hole  
Date well completed 1-9-75 19  
Application for plugging filed 1-9-75 19  
Application for plugging approved 1-9-75 19  
Plugging commenced 1-9-75 19  
Plugging completed 1-9-75 19  
Reason for abandonment of well or producing formation Dry Hole

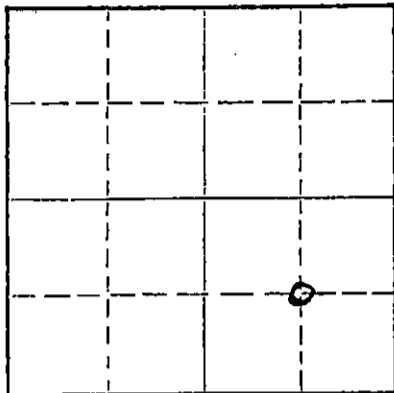

Locate well correctly on above  
Section Plat

If a producing well is abandoned, date of last production 19  
Was permission obtained from the Conservation Division or its agents before plugging was commenced? Yes

Name of Conservation Agent who supervised plugging of this well G.R. Biberstein  
Producing formation \_\_\_\_\_ Depth to top \_\_\_\_\_ Bottom \_\_\_\_\_ Total Depth of Well 5323 Feet  
Show depth and thickness of all water, oil and gas formations.

OIL, GAS OR WATER RECORDS

CASING RECORD

FORMATION	CONTENT	FROM	TO	SIZE	PUT IN	PULLED OUT
	RECEIVED			8 5/8	355	None
	STATE CORPORATION COMMISSION			13 3/8	84	None
	6-15-75					
	1-16-75					
	CONSERVATION DIVISION					
	Wichita, Kansas					

Describe in detail the manner in which the well was plugged, indicating where the mud fluid was placed and the method or methods used in introducing it into the hole. If cement or other plugs were used, state the character of same and depth placed, from \_\_\_\_\_ feet to \_\_\_\_\_ feet for each plug set.

40 sacks at 300'

15 sacks at 40'

Job completed at 10:30 AM 1-9-74

(If additional description is necessary, use BACK of this sheet)

Name of Plugging Contractor Pickrell Drilling Company  
Address 705 FOURTH NAT'L BANK BLDG. WICHITA, KS. 67202

STATE OF KANSAS, COUNTY OF SEDGWICK, ss.  
C. W. Sebitts (employee of owner) or (owner or operator) of the above-described

well, being first duly sworn on oath, says: That I have knowledge of the facts, statements, and matters herein contained and the log of the above-described well as filed and that the same are true and correct. So help me God.

(Signature) *C. W. Sebitts*

C.W. Sebitts 705 4th Nat'l Bank Bldg. Wichita, Ks. 67202  
(Address)

SUBSCRIBED AND SWORN TO before me this 14 day of January, 19 75

My commission expires August 19, 1975

*Helen L. Martin*  
Helen L. Martin Notary Public.

15-833-20168-0000  
**ROTARY DRILLING LOG**

**COMPANY:** PICKRELL DRILLING COMPANY  
705 Fourth National Bank Bldg.  
Wichita, Kansas 67202

**LOCATION:** Butts "B" #1  
C SE/4 Sec. 5-34S-20W  
Comanche County, Kansas

Rotary Drilling Commenced 12-21-74

Rotary Drilling Completed 1-9-75

**CONTRACTOR:** PICKRELL DRILLING COMPANY  
Wichita, Kansas

**CASING RECORD:** 13 3/8" conductor pipe at 84' with 200 sacks.  
(5 joints) 8 5/8" casing set at 605' with 355 sacks cement. Job completed 12-22-74.

**LOG**

(Figures indicate bottom of formation — measurements from top of rotary bushing.)

150	Top Soil Red Beds	5103	Lime & Shale
287	Loss of Circ.	5211	Shale & Lime
580	Shale	5234	Shale & Sandy Shale
615	Dry Drlg.	5323	Lime & Chert.
1290	Shale		
1686	Shale		
1997	Shale & Lime Stone		
2227	Shale & Lime Stks.		
2505	Shale & Lime		
2570	Lime & Shale		
2667	Lime & Shale		
2810	Lime & Shale		
2960	Lime & Shale		
3107	Lime & Shale		
3310	Lime & Shale		
3460	Shale & Lime		
3622	Lime & Shale		
3735	Lime & Shale		
3817	Lime & Shale		
3889	Lime & Shale		
4025	Lime & Shale		
4110	Shale & Lime		
4160	Shale & Lime		
4250	Lime & Shale		
4355	Lime & Shale		
4455	Lime & Shale		
4550	Lime & Shale		
4630	Lime		
4722	Lime		
4815	Lime		
4895	Lime		
4976	Lime		

**RECEIVED**  
STATE CORPORATION COMMISSION  
16 19/75  
1-16-75  
CONSERVATION DIVISION  
Wichita, Kansas

The undersigned, C.W. SEBITS, Attorney-in-Fact for PICKRELL DRILLING COMPANY, hereby certifies in behalf of said Company, that the above is a true and correct log of the formation encountered in drilling the above well as reflected by the Daily Drilling Reports.

PICKRELL DRILLING COMPANY  
By [Signature]  
Attorney-in-Fact  
C.W. Sebitts

STATE OF KANSAS }  
COUNTY OF SEDGWICK } ss.:

On this 14 day of January, 1975, before me the undersigned, a Notary Public, in and for

the County and State aforesaid, personally appeared C.W. Sebitts, to me known to be the identical person who subscribed the name of PICKRELL DRILLING COMPANY to the foregoing instrument as its Attorney-in-Fact and acknowledged to me that he executed the same as his free and voluntary act and deed, and as the free and voluntary act and deed of such company, for the uses and purposes therein set forth.

Given under my hand and seal of office the day and year last above written.

My commission expires: August 19, 1975

[Signature]  
Helen L. Martin  
Notary Public