

STATE OF KANSAS
STATE CORPORATION COMMISSION
200 Colorado Derby Building
Wichita, Kansas 67202

WELL PLUGGING RECORD
K.A.R.-82-3-117

API NUMBER 15-033-20,321-0000

LEASE NAME Schumacher

WELL NUMBER 2

1320 Ft. from N Section Line

660 Ft. from S Section Line

SEC. 18 TWP. 34S RGE. 20 (E) or (W)

COUNTY Comanche

Date Well Completed _____

Plugging Commenced 1/31/86

Plugging Completed 2/7/86

TYPE OR PRINT
NOTICE: Fill out completely
and return to Cons. Div.
office within 30 days.

LEASE OPERATOR TXO

ADDRESS 155 N. Market, Suite 1000, Wichita, KS 67202

PHONE# (316) 269-7600 OPERATORS LICENSE NO. 5171

Character of Well Gas

(Oil, Gas, D&A, SWD, Input, Water Supply Well)

Did you notify the KCC/KDHE Joint District Office prior to plugging this well? yes

Which KCC/KDHE Joint Office did you notify? Dodge City, KS

Is ACO-1 filed? _____ If not, is well log attached? _____

Producing Formation _____ Depth to Top _____ Bottom _____ T.O. 5530

Show depth and thickness of all water, oil and gas formations.

OIL, GAS OR WATER RECORDS

CASING RECORD

Formation	Content	From	To	Size	Put in	Pulled out
				8 5/8	582	None 400sx
				4 1/2	5509	4144

Describe in detail the manner in which the well was plugged, indicating where the mud fluid was placed and the method or methods used in introducing it into the hole. If cement or other plugs were used, state the character of same and depth placed, from _____ feet to _____ feet each set.

Sand from 5492 to 5380, 4sx cement with dump bailer from 5380 to 5350 pump in 3sx hulls, 15sx jell, 50sx cement, 10sx jell, 1sx hulls, 8 5/8 plug, 150sx cement

Jerry Pritchard on location (nobody from Clarke)
(if additional description is necessary, use BACK of this form.)

Name of Plugging Contractor Clarke Corp. License No. 5105


Address P.O. Box 187, Medicine Lodge, KS 67104

STATE OF Kansas COUNTY OF Barber, ss.

Elmo Morgenstern (Employee of Operator) or (Operator) of above-described well, being first duly sworn on oath, says: That I have knowledge of the facts, statements, and matters herein contained and the log of the above-described well as filed that the same are true and correct, so help me God.

(Signature) *Elmo Morgenstern*

(Address) Medicine Lodge, KS 67104

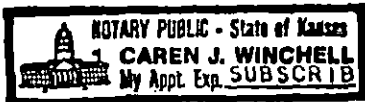

AND SWORN TO before me this 12 day of February, 19 86

Caren J. Winchell
Notary Public

My Commission Expires: June 29, 1987

FEB 19 1986
2-19-86
CONSERVATION DIVISION

KANSAS DRILLERS LOG

API No. 15 — 033 — 20,321 — **GEOL**
 County Number

Operator
 Texas Oil & Gas Corp.

Address
 200 West Douglas, Suite 300, Wichita, KS 67202

Well No. #2 Lease Name Schumacher

Footage Location
 1320 feet from (N) (S) line 660 feet from (E) (W) line


Principal Contractor Xplor Drilling Geologist Core Laboratories

Spud Date 10-27-79 Total Depth 5530' P.B.T.D. 5496'

Date Completed 11-21-79 Oil Purchaser N/A

S. 18 T. 34 R. 30 W

FILE
 County Comanche

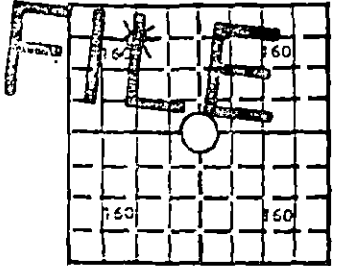

Locate well correctly
 Elev.: Gr. 1845'

DF _____ KB 1853'

CASING RECORD

Report of all strings set— surface, intermediate, production, etc.

Purpose of string	Size hole drilled	Size casing set (in O.D.)	Weight lbs/ft.	Setting depth	Type cement	Sacks	Type and percent additives
Surface	12-1/4"	8-5/8"	24#	590'		600	
Production		4-1/2"	10.5#	5517'		250	

LINER RECORD

PERFORATION RECORD

Top, ft.	Bottom, ft.	Sacks cement	Shots per ft.	Size & type	Depth interval
N/A	N/A	N/A	2 JSPF	4-1/2"	5430-34'

TUBING RECORD

Size	Setting depth	Packer set at
2-3/8"	5426'	
2-3/8"	5350'	

ACID, FRACTURE, SHOT, CEMENT SQUEEZE RECORD

Amount and kind of material used	Depth interval treated
500 gals acetic acid	5430-34'

RECEIVED

STATE GEOLOGICAL SURVEY OF KANSAS

INITIAL PRODUCTION

Date of first production Shut-in	Producing method (flowing, pumping, gas lift, etc.) flowing	OCT 27 1979 10-29-80	
RATE OF PRODUCTION PER 24 HOURS	Oil trace	Gas 1200 bbls.	Water none
Disposition of gas (vented, used on lease or sold) Shut-in	Producing interval (s) 5430-34'	MCF	Gas-oil ratio N/A

INSTRUCTIONS: As provided in KCC Rule 82-2-125, within 90 days after completion of a well, one completed copy of this Drillers Log shall be transmitted to the State Geological Survey of Kansas, 4150 Monroe Street, Wichita, Kansas 67209. Copies of this form are available from the Conservation Division, State Corporation Commission, 3830 So. Meridian (P.O. Box 17027), Wichita, Kansas 66217. Phone AC 316-522-2206. If confidential custody is desired, please note Rule 82-2-125. Drillers Logs will be on open file in the Oil and Gas Division, State Geological Survey of Kansas, Lawrence, Kansas 66044.