


STATE OF KANSAS
STATE CORPORATION COMMISSION

WELL PLUGGING RECORD

Give All Information Completely
Make Required Affidavit
Mail or Deliver Report to
Conservation Division
State Corporation Comm.
245 North Water
Wichita, KS 67202

Comanche County, Sec. 18 Twp. 34S Rge. 20W E/W
Location as "NE/CNW $\frac{1}{4}$ SW $\frac{1}{4}$ " or footage from lines Approximately
1320' FNL and 990' FEL

Lease Owner Texas Oil & Gas Corporation
Lease Name ELY ESTATE Well No. 1
Office Address 200 W. Douglas, Suite 300, Wichita, KS 67202
Character of Well (Completed as Oil, Gas or Dry Hole) Dry Hole

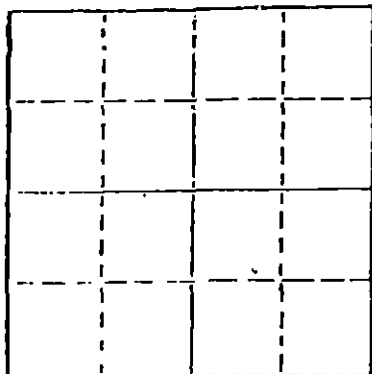

Locate well correctly on above
Section Plot

Date Well completed Nov. 18 1980
Application for plugging filed Nov. 18 1980
Application for plugging approved Nov. 18 1980
Plugging commenced Nov. 18 1980
Plugging completed Nov. 18 1980
Reason for abandonment of well or producing formation _____

If a producing well is abandoned, date of last production 19

Was permission obtained from the Conservation Division or
its agents before plugging was commenced? Yes

Name of Conservation Agent who supervised plugging of this well Bill Owens
Producing formation _____ Depth to top _____ Bottom _____ Total Depth of Well _____
Show depth and thickness of all water, oil and gas formations.

OIL, GAS OR WATER RECORDS

CASING RECORD

FORMATION	CONTENT	FROM	TO	SIZE	PUT IN	PULLED OUT
		0	634'	8 5/8"	16 ints	

Describe in detail the manner in which the well was plugged, indicating where the mud fluid
was placed and the method or methods used in introducing it into the hold. If cement or other
plugs were used, state the character of same and depth placed, from _____ feet to
_____ feet for each plug-set. 50 Sacks Common at 630', bridge and 10 sacks common
at 40', 5 sacks common in rat hole, 5 sacks common in Mouse hole.

RECEIVED
NOV 21 1980
11-21-80
CONSERVATION DIVISION

(If additional description is necessary, use BACK of this sheet)

Name of Plugging Contractor Dowell

STATE OF KANSAS COUNTY OF SEDGWICK, ss.
Kirby C. Evers, Vice President (employee of owner) or (owner or operator)
of the above-described well, being first duly sworn on oath, says: That I have knowledge of
the facts, statements, and matters herein contained and the log of the above-described well
as filed and that the same are true and correct. So help me God.

(Signature) Kirby C. Evers
P. O. Box 18611, Wichita, Kansas 67207
(Address)

SUBSCRIBED AND SWORN TO before me this 21st day of November, 19 80.

My commission expires MY APPOINTMENT EXPIRES NOV 28, 1980
Mary Kay Oeding Notary Public.

OPERATOR: Texas Oil & Gas Corporation
CONTRACTOR: Xplor Drilling Company, Inc.

COMMENCED: November 6, 1980
COMPLETED: November 18, 1980
CASING RECORD: 8 5/8" at 634'
(16 jnts #24)

<u>FORMATION</u>	<u>FROM</u>	<u>TO</u>
Red Bed	0	2202
Shale	2202	2243
Anty. & Shale	2243	2300
Shale	2300	2776
Dolo & Shale	2776	3046
Lime & Shale	3046	5500

RECEIVED
STATE COMMISSION ON OIL & GAS

NOV 24 1980

STATE OF KANSAS)
) SS:
COUNTY OF SEDGWICK)

11-24-80
CONSERVATION DIVISION
WELL LOGS

I certify that this is a true and correct copy of the Driller's Log on the well drilled 1320' FNL & 990' FEL, Sec. 18-34S-20W, Comanche Co., Ks. to the best of my knowledge and belief.

XPLOR DRILLING COMPANY

Kirby C. Evers
Kirby C. Evers, Vice President

Subscribed and sworn to before me this 21st day of November, 1980.

Mary Kay Cordery

MY APPOINTMENT EXPIRES NOV 28, 1980

My appointment expires: