

15-833-10042-0000

STATE OF KANSAS  
STATE CORPORATION COMMISSION

Give All Information Completely  
Make Required Affidavit  
Mail or Deliver Report to:  
Conservation Division  
State Corporation Commission  
211 No. Broadway  
Wichita, Kansas

WELL PLUGGING RECORD

Comanche County, Sec. 19 Twp. 34S Rge.        (E) 20 (W)

Location as "NE/CNW/SW" or footage from lines C SW NE

Lease Owner Sunray Mid-Continent Oil Company

Lease Name Robbins Well No. 1

Office Address Box # 788, Great Bend, Kansas

Character of Well (completed as Oil, Gas or Dry Hole) Dry Hole

Date well completed March 1, 19 57

Application for plugging filed March 5, 19 57

Application for plugging approved March 4, 19 57


Plugging commenced March 1, 19 57

Plugging completed March 1, 19 57

Reason for abandonment of well or producing formation       

If a producing well is abandoned, date of last production        19       

Was permission obtained from the Conservation Division or its agents before plugging was commenced? Yes

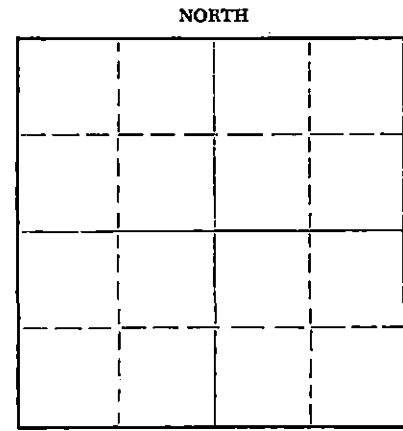

Locate well correctly on above Section Plat

Name of Conservation Agent who supervised plugging of this well M. A. Rives

Producing formation        Depth to top        Bottom        Total Depth of Well 5571' Feet

Show depth and thickness of all water, oil and gas formations.

OIL, GAS OR WATER RECORDS

CASING RECORD

FORMATION	CONTENT	FROM	TO	SIZE	PUT IN	PULLED OUT
				20"	155'	None
				13 3/4"	579'	None
				8 5/8"	1601'	None

Describe in detail the manner in which the well was plugged, indicating where the mud fluid was placed and the method or methods used in introducing it into the hole. If cement or other plugs were used, state the character of same and depth placed, from        feet to        feet for each plug set.

Hole filled w/ heavy drlg mud to 500', 1/4 sack hull, set Halliburton Wooden plug w/ 35 sacks cement. Filled hole with heavy drlg mud to 35', sack loose hulls, set Halliburton wooden plug, filled hole w/ cement to bottom of cellar. Plugging completed.

Log attached.

(If additional description is necessary, use BACK of this sheet)

Name of Plugging Contractor Halliburton Oil Well Cementing Co.

Address       

STATE OF KANSAS, COUNTY OF BARTON, ss.

N. E. Montgomery (employee of owner) or (~~owner~~) of the above-described

well, being first duly sworn on oath, says: That I have knowledge of the facts, statements, and matters herein contained and the log of the above-described well as filed and that the same are true and correct. So help me God.

(Signature) N. E. Montgomery

Box # 788, Great Bend, Kansas  
(Address)

SUBSCRIBED AND SWORN to before me this 7 day of March, 19 57

My commission expires Dec. 24, 1960

Houlihan  
Notary Public.

PLUGGING  
FILE SEC. 19 T. 34 R. 20W  
BOOK PAGE 145 LINE 6

RECEIVED  
STATE CORPORATION COMMISSION  
MAR 8 - 1957  
3-8-57  
CONSERVATION DIVISION  
Wichita, Kansas

15-033-10042-0000

Sunray Mid-Continent Oil Company  
Tulsa, Oklahoma

Tulsa, Oklahoma  
March 4, 1957

CONTRACTOR: Stickle Drilling Company  
Drilling Commenced: January 29, 1957  
Drilling Completed: March 1, 1957

G. W. Robbins #1 -  
NW/4 - Sec. 19-34S-20W,  
Comanche County, Kansas.

DRILLERS LOG

Depth Figures Indicate Base of Formation

Surface	95
Shale	195
Red Bed	600
Shale	760
Shale & Shells	970
Shells & Shale	1325
Shale & Shells	1415
Shells & Shale	1570
Shale & Shells	1603
Shale	2035
Shale & Lime	2190
Lime & Shale	2715
Lime	3012
Lime & Shale	3099
Lime	3341
Lime & Shale	3402
Lime	3481
Lime & Shale	3978
Sandy Shale	4080
Shale	4180
Lime & Shale	4410
Sandy Lime & Shale	4506
Lime & Shale	4639
Sandy Lime & Shale	4665
Lime	4949
Shale & Lime	5021
Lime & Shale	5171
Lime	5213
Lime & Shale	5230
Lime	5280
Lime & Shale	5341
Lime	5403
Lime, Shale & Sand	5455
Lime, Sandy Shale	5510
Lime & Shale	5571 TD

I, Frank E. Stickle, hereby certify the above to be a true and complete Driller's Log of Sunray Mid-Continent Oil Company's G. W. Robbins #1 - NW/4 of Section 19-34S-20W, Comanche County, Kansas.

Frank E. Stickle  
Frank E. Stickle

Lillian T. Borham  
Notary Public

February 13, 1960  
My Commission Expires

PLUGGING  
FILE SEC. 19 T. 34 R. 20W  
BOOK PAGE 145 LINE 6

RECEIVED  
STATE OF KANSAS  
COMMISSION  
MAR 3 1957  
3-3-57  
CONSERVATION DIVISION  
Wichita, Kansas