

WELL PLUGGING RECORD

Give All Information Completely
Make Required Affidavit
Mail or Deliver Report to:
Conservation Division
State Corporation Commission
212 No. Market
Wichita, Kansas

Comanche County, Sec. 34 Twp. 34S Rge. (E) 16 (W)
Location as "NE/CNW/SW" or footage from lines C-SE-NW

Lease Owner Zenith Drilling Corporation, Inc.

Lease Name Lucas Well No. 1-34

Office Address Suite 600 - 200 W. Douglas, Wichita, Kansas 67202

Character of Well (completed as Oil, Gas or Dry Hole) Dry Hole

Date well completed July 27, 19 71

Application for plugging filed July 26, 19 71

Application for plugging approved July 30, 19 71


Plugging commenced July 26, 19 71

Plugging completed July 27, 19 71

Reason for abandonment of well or producing formation Dry

If a producing well is abandoned, date of last production _____ 19 _____

Was permission obtained from the Conservation Division or its agents before plugging was commenced? yes

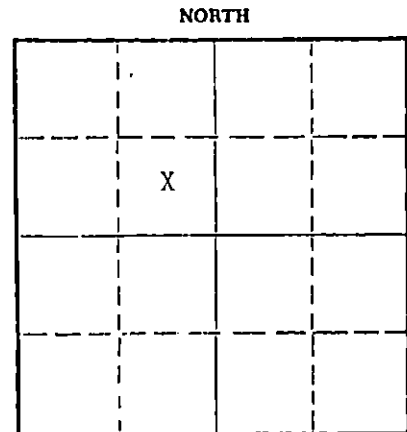

Locate well correctly on above Section Plat

Name of Conservation Agent who supervised plugging of this well G. Russell Biberstein, Attica, Kansas 67009

Producing formation _____ Depth to top _____ Bottom _____ Total Depth of Well 525.8 Feet

Show depth and thickness of all water, oil and gas formations.

OIL, GAS OR WATER RECORDS

CASING RECORD

FORMATION	CONTENT	FROM	TO	SIZE	PUT IN	PULLED OUT
				8 5/8"	322.53	-0-

Describe in detail the manner in which the well was plugged, indicating where the mud fluid was placed and the method or methods used in introducing it into the hole. If cement or other plugs were used, state the character of same and depth placed, from _____ feet to _____ feet for each plug set.

- 35 sx. @600'
- 25 sx. @300'
- 10 sx. @ 40'
- 2 sx. rat hole
- 2 sx. mouse hole

RECEIVED
STATE CORPORATION COMMISSION
AUG 5 7 1971
CONSERVATION DIVISION
Wichita, Kansas

(If additional description is necessary, use BACK of this sheet)


Name of Plugging Contractor Garvey Drilling Company
Address Great Bend, Kansas

STATE OF Kansas COUNTY OF Sedgwick, ss.
I, C. Robert Buford, President _____ (owner or operator) of the above-described

well, being first duly sworn on oath, says: That I have knowledge of the facts, statements, and matters herein contained and the log of the above-described well as filed and that the same are true and correct. So help me God.

(Signature) C. Robert Buford
Suite 600 - 200 W. Douglas, Wichita, Kansas
(Address)

Subscribed and Sworn to before me this 3rd day of August, 1971

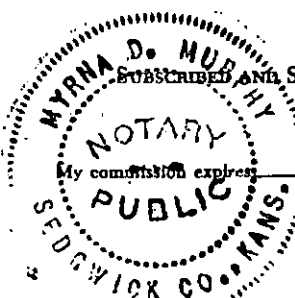

Myrna D. Murphy
My commission expires August 15, 1971
Notary Public.

15-033-20097-0000

WELL LOG

COMPANY Zenith Drilling Company

BEC. 34 T. 34S. R. 16W

FARM Lucas NO. 1-34

LOG. SE NW

TOTAL DEPTH 5260'

COUNTY Comanche, Kansas

COMM. 7-15-71 COMP. 7-27-71

CONTRACTOR Garvey Drilling Company

	X		

CASING
8 5/8" @ 314.53' w/300sx

ELEVATION

PRODUCTION D & A

FIGURES INDICATE BOTTOM OF FORMATIONS

- .37' Red Bed & Rock
- .250' Red Bed, Gyp, & Sand
- .1422' Shale & Shells
- 1815' Shale & Lime
- 2310' Lime & Shale
- 2590' Lime
- .2715' Lime & Shale
- 3100' Shale & Lime
- 3285' Lime & Shale
- .3725' Shale & Lime
- 3880' Lime & Shale
- 4275' Shale & Lime
- 4358' Lime & Shale
- .4690' Lime
- .5258' Lime & Chert
- 5260' Lime & Chert
- .5260' RTD

RECEIVED
STATE CORPORATION COMMISSION
AUG 5 1971
CONSERVATION DIVISION
Wichita, Kansas

State of Kansas }
County of Barton } SS

I, Charlene Marker of Garvey Drilling Company

upon oath state the above and foregoing is a true and correct copy of the log of the Lucas No. 1-34 well.

Charlene Marker

Subscribed and sworn to before me this 2nd day of August 1971

My Commission Expires: July 8, 1974

Archie C. [Signature]
NOTARY PUBLIC