

CARD MUST BE TYPED

State of Kansas  
**NOTICE OF INTENTION TO DRILL**

CARD MUST BE SIGNED

(see rules on reverse side)

Starting Date: December 10 1984  
month day year

API Number is 033-20,667-000  
330' N of Center  East

OPERATOR: License # 6528  
Name R. J. Patrick Operating Company  
Address P. O. Box 1314  
City/State/Zip Liberal, Ks. 67901  
Contact Person R. J. Patrick  
Phone (316) 624-8483

*NE NE* NW/NW 1/4 Sec. 1. Twp. 34. S, Rge 20.  West

5030 Ft North from Southeast Corner of Section  
4730 Ft West from Southeast Corner of Section  
(Note: Locate well on Section Plat on reverse side)

CONTRACTOR: License # 6666  
Name N R G Drilling, Inc.  
City/State Liberal, Ks. 67901

Nearest lease or unit boundary line 330 550 feet.  
County Comanche

Lease Name Ralph Baker Well# 4

Well Drilled For: Well Class: Type Equipment:  
 Oil  Swd  Infield  Mud Rotary  
 Gas  Inj  Pool Ext.  Air Rotary  
 OWWO  Expl  Wildcat  Cable

Domestic well within 330 feet:  yes  no  
Municipal well within one mile:  yes  no

If OWWO: old well info as follows:  
Operator  
Well Name  
Comp Date Old Total Depth  
Projected Total Depth 4,850 feet  
Projected Formation at TD Swope  
Expected Producing Formations Amazonia & Swope

Depth to Bottom of fresh water 350 feet  
Lowest usable water formation Whitehorse Form.  
Depth to Bottom of usable water 200 feet  
Surface pipe by Alternate: 1  2   
Surface pipe to be set 650 feet  
Conductor pipe if any required 40 feet  
Ground surface elevation 1811 feet MSL  
This Authorization Expires 6-10-85  
Approved By 12-10-84 *R. J. Patrick*

I certify that we will comply with K.S.A. 55-101, et seq., plus eventually plugging hole to K.C.C. specifications.

Date 12/7/84 Signature of Operator or Agent


*R. J. Patrick* Title Owner

*m Hc/ROHE 12/10/84* Form C-1 4/84

Must be filed with the K.C.C. five (5) days prior to commencing well  
 This card void if drilling not started within six (6) months of date received by K.C.C.

**Important procedures to follow :**

**A Regular Section of Land  
 1 Mile = 5,280 Ft.**

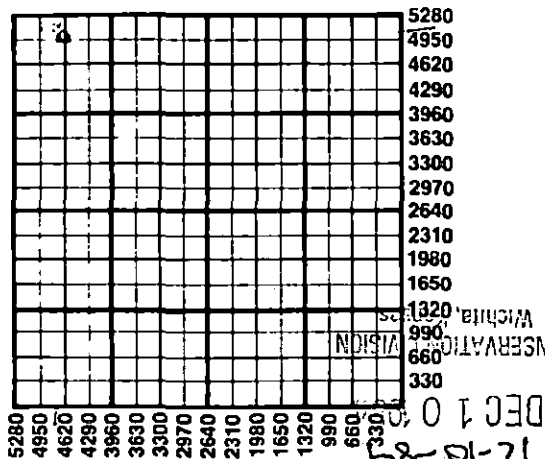

1. Notify District office before setting surface casing.
2. Set surface casing by circulating cement to the top.
3. File completion forms ACO-1 with K.C.C. within 90 days of well completion, following instructions on ACO-1, side 1, and including copies of wireline logs.
4. Notify District office 48 hours prior to old well workover or re-entry.
5. Prior to plugging, prepare a plugging plan, then obtain agreement from the appropriate district office for an approved plugging plan.
6. Submit plugging report (CP-4) to K.C.C. after plugging is completed.
7. Obtain an approved injection docket number before disposing of salt water.
8. Notify K.C.C. within 10 days when injection commences or terminates.
9. If an alternate 2 completion, cement in the production pipe from below any usable water to surface within 120 days of spud date.

RECEIVED  
 STATE CORPORATION COMMISSION  
 12-10-84  
 DEC 10 1984

State Corporation Commission of Kansas  
 Conservation Division  
 200 Colorado Derby Building  
 Wichita, Kansas 67202  
 (316) 263-3238