

FORM MUST BE TYPED

FORM MUST BE SIGNED

ALL BLANKS MUST BE FILLED

FOR KCC USE:

EFFECTIVE DATE: 6-20-98

DISTRICT # 1

SEAL: Yes No

State of Kansas

NOTICE OF INTENTION TO DRILL

Must be approved by the K.C.C. five (5) days prior to commencing well

Expected Spud Date June 22 1998
month day yearOPERATOR: License #31691.....
Name: ...Coral Coast Petroleum, L.C.....
Address: ...200 E. 1st...#001.....
City/State/Zip: Wichita, Kansas 67202.....
Contact Person:Dan Reynolds.....
Phone: 316-269-1233.....CONTRACTOR: License #:5929.....
Name: Duke Drilling Inc.....

Well Drilled For:	Well Class:	Type Equipment:	
<input checked="" type="checkbox"/> Oil	Enh Rec	<input checked="" type="checkbox"/> Infield	<input checked="" type="checkbox"/> Mud Rotary
<input checked="" type="checkbox"/> Gas	Storage	Pool Ext.	Air Rotary
<input checked="" type="checkbox"/> SWW	Disposal	Wildcat	Cable
Seismic; # of Holes	Other		
Other			

If SWW: old well information as follows:
 Operator:RJ. Patrick.....
 Well Name:#4-Ora-Baker.....
 Comp. Date: ..3-9-82.. old Total Depth .4830.....

Directional, Deviated or Horizontal wellbore? yes ..X.. no

If yes, true vertical depth.....

Bottom Hole Location:.....

Spot 150 W. NE NE 2 34 20 East
Sec Twp S. Rg. X West660' feet from South/North line of Section
810' feet from East/West line of SectionIS SECTION REGULAR IRREGULAR?

(NOTE: Locate well on the Section Plat on Reverse Side)

County: Comanche

Lessee Name: Ora Baker Well #: 4

Field Name: Collier Flats SW1/4

Is this a Prorated/Spaced Field? yes ..X.. no

Target Formation(s): Arbuckle

Nearest lease or unit boundary: 660

Ground Surface Elevation: 1806 feet MSL

Water well within one-quarter mile: yes ..X.. no

Public water supply well within one mile: yes ..X.. no

Depth to bottom of fresh water: 100

Depth to bottom of usable water: 180

Surface Pipe by Alternate: ..X.. 1 2

Length of Surface Pipe Planned to be set: wa.s. 642

Length of Conductor pipe required: none

Projected Total Depth: 6400

Formation at Total Depth: Arbuckle

Water Source for Drilling Operations:

.... well farm pond ..X.. other

DW permit #:

Will cores be taken? yes ..X.. no

If yes, proposed zone:

AFFIDAVIT

The undersigned hereby affirms that the drilling, completion and eventual plugging of this well will comply with K.S.A. 55-101, et. seq.

It is agreed that the following minimum requirements will be met:

1. Notify the appropriate district office prior to spudding of well;
2. A copy of the approved notice of intent to drill shall be posted on each drilling rig;
3. The minimum amount of surface pipe as specified below shall be set by circulating cement to the top; in all cases surface pipe shall be set through all unconsolidated materials plus a minimum of 20 feet into the underlying formation;
4. If the well is dry hole, an agreement between the operator and the district office on plug length and placement is necessary prior to plugging;
5. The appropriate district office will be notified before well is either plugged or production casing is cemented in;
6. IF AN ALTERNATE II COMPLETION, PRODUCTION PIPE SHALL BE CEMENTED FROM BELOW ANY USABLE WATER TO SURFACE WITHIN 120 DAYS OF SPUD DATE. IN ALL CASES, NOTIFY DISTRICT OFFICE PRIOR TO ANY CEMENTING.

I hereby certify that the statements made herein are true and to the best of my knowledge and belief.

Date: ..6-8-98..... Signature of Operator or Agent: *Danell Reynolds*

Title: Managing Member

FOR KCC USE:

API # 15-

033-20550 0001

Conductor pipe required: NONE feetMinimum surface pipe required: 642 feet per Alt. 1 Approved by: *JK 6-15-98*This authorization expires: 12-15-98
(This authorization void if drilling not started within 6 months of effective date.)Spud date: Agents: *JK*

REMEMBER TO:

- File Drill Pit Application (Form CPP-1) with Intent to Drill;
- File Completion Form ACD-1 within 120 days of spud date;
- File acreage attribution plat according to field proration orders;
- Notify appropriate district office 48 hours prior to workover or re-entry;
- Submit plugging report (CP-4) after plugging is completed;
- Obtain written approval before disposing or injecting salt water.

Mail to: Conservation Division, 200 Colorado Derby Building, 202 W. First St., Wichita, Kansas 67202-1236.

RECEIVED
KANSAS CORP CO.
12-35
1998

12

FC

MOZ

IN ALL CASES INTENDED WELL ON THE PLAT BELOW
PLAT OF ACREAGEABLE TO A WELL IN A PRORATED OR SPACED FIELD

If the intended well is in a prorated or spaced field, please fully complete this side of the form. If the intent is in a prorated or spaced field complete the plat below showing that the well will be located in relationship to other wells producing from the common source of supply show all the wells within 1 mile of the boundaries of the proposed acreage attributable for gas wells and within 1/2 mile of the boundaries of the proposed acreage a unit for oil wells.

API NO. 15-

OPERATOR _____

LEASE _____

WELL NUMBER _____

FIELD _____

LOCATION OF WELL: COUNTY _____

feet from south/north line of section _____

feet from east/west line of section _____

SECTION _____ TWP _____ RG _____



NUMBER OF ACRES ATTRIBUTABLE _____

QTR/QTR/QTR OF ACREAGE _____

IS SECTION REGULAR or IRREGULAR
IF SECTION IS IRREGULAR, LOCATE WELL FROM NEAREST CORNER BOUNDARY

Section corner used: NE NW SE SW
PLAT

(Show location of the acreage attributable acreage for prorated or spaced wells.)
(Show for the nearest lease or unit boundary line.)

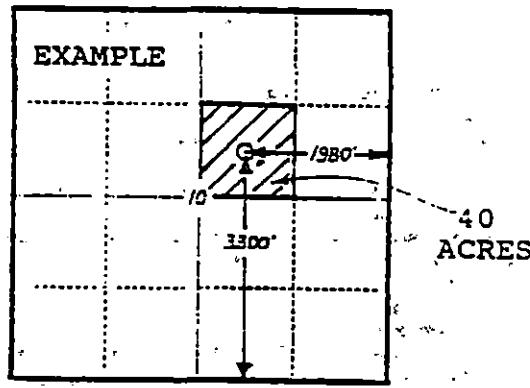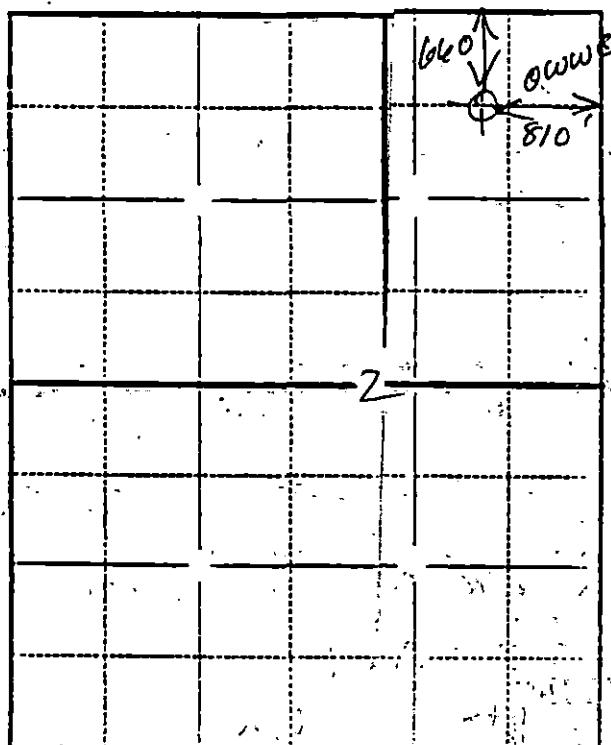

In plotting the proposed well, you must show:

- 1) The manner in which you depicted the plat by identifying section lines, i.e. 1 section, 1 section surrounding sections, 4 sections, etc.;
- 2) the distance of the drilling location from the section's south/north and east/west lines; and
- 3) the distance to the lease or unit boundary line.