

FORM MUST BE TYPED  
FORM C-1 12/88

State of Kansas  
NOTICE OF INTENTION TO DRILL

FORM MUST BE SIGNED  
ALL BLANKS MUST BE FILLED

Must be approved by the K.C.C. five (5) days prior to commencing well

60'S & 120'W of  
\*\*\* C... S 1/2 SW Sec 31 Twp 34 S, Rg 16 X West

Expected Spud Date ..... August 1, 1989  
month day year

\*\*\* ..... 600 ..... feet from South Line of Section  
\*\*\* ..... 4080 ..... feet from East Line of Section  
(Note: Locate well on Section Plat Below)

OPERATOR: License # ..... 5171  
Name: ..... TXO PRODUCTION CORP.  
Address: ..... 1660 Lincoln St. - Suite 1800  
City/State/Zip: ..... Denver, Colorado 80246  
Contact Person: ..... Corey West  
Phone: ..... 303/861-4246

County: ..... Comanche  
Lease Name: ..... Beeley "B" Well #: ..... 1  
Field Name: ..... Wildcat  
Is this a Prorated Field? ..... yes  no   
Target Formation(s): ..... Mississippi

CONTRACTOR: License #: ..... 5864  
Name: ..... LOBO DRILLING COMPANY

\*\*\* Nearest lease or unit boundary: ..... 600  
Ground Surface Elevation: ..... N/A ..... feet MSL  
Domestic well within 330 feet: ..... yes  no   
Municipal well within one mile: ..... yes  no   
Depth to bottom of fresh water: ..... 100'  
Depth to bottom of usable water: ..... 180'  
Surface Pipe by Alternate: ..... X 1 ..... 2  
Length of Surface Pipe Planned to be set: ..... 950'  
Length of Conductor pipe required: ..... None  
Projected Total Depth: ..... 5400'  
Formation at Total Depth: ..... Mississippi  
Water Source for Drilling Operations:  
X well ..... farm pond ..... other  
DWR Permit #: .....  
Will Cores Be Taken?: ..... yes  no   
If yes, proposed zone: .....

Well Drilled For: Well Class: Type Equipment:  
X Oil ... Inj ... Infield X Hud Rotary  
... Gas ... Storage ... Pool Ext. ... Air Rotary  
... OAWO ... Disposal X Wildcat ... Cable  
... Seismic; ... # of Holes

If OAWO: old well information as follows:  
Operator: .....  
Well Name: .....  
Comp. Date: ..... Old Total Depth .....

Directional, Deviated or Horizontal wellbore? .... yes X no  
If yes, total depth location: .....  
WAS: C-SW-SW; 660' FS L; 4620' FEL  
nearest boundary 660'

AFFIDAVIT


The undersigned hereby affirms that the drilling, completion and eventual plugging of this well will comply with K.S.A. 55-101, et. seq.

It is agreed that the following minimum requirements will be met:

- 1. The appropriate district office shall be notified before setting surface pipe;
- 2. The minimum amount of surface pipe as specified above shall be set by circulating cement to the top; in all cases surface pipe shall be set through all unconsolidated materials plus a minimum of 20 feet into the underlying formation;
- 3. If the well is dry, a plugging proposal shall be submitted to the district office. An agreement between the operator and the district office on plug length and placement is necessary prior to plugging;
- 4. The appropriate district office will be notified before well is either plugged or production casing is cemented in;
- 5. If an Alternate II completion, production pipe shall be cemented from below any usable water to surface within 120 days of spud date. In all cases, notify district office prior to any cementing.

I hereby certify that the statements made herein are true and to the best of my knowledge and belief.

Date: July 26, 1989 Signature of Operator or Agent: Sally R. Byers Title: Agent

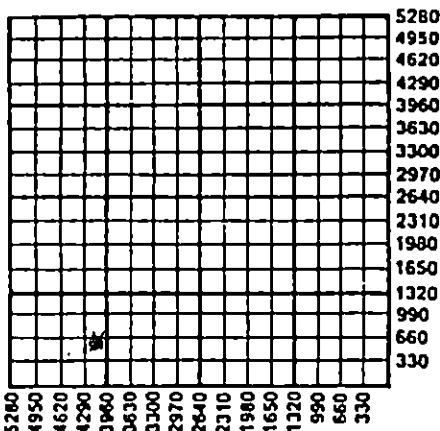

RECEIVED  
STATE CORPORATION COMMISSION  
JUL 26 1989  
7-26-89  
CONSERVATION DIVISION  
Wichita, Kansas

FOR KCC USE:  
API # 15- 033-20,751-0000 ✓  
Conductor pipe required NONE feet  
Minimum surface pipe required 200' feet per Alt. 10X  
Approved by: DPW 7-26-89; ORIG 7-19-89  
EFFECTIVE DATE: 7-24-89  
This authorization expires: 7-19-90  
(This authorization void if drilling not started within 6 months of effective date.)  
Spud date: \_\_\_\_\_ Agent: \_\_\_\_\_

21  
34  
low

REMEMBER TO:

- File Drill Pit Application (form CDP-1) with Intent to Drill;
- File Completion Form ACO-1 within 120 days of spud date;
- File acreage attribution plat according to field proration orders;
- Notify appropriate district office 48 hours prior to workover or re-entry;
- Submit plugging report (CP-4) after plugging is completed;
- Obtain written approval before disposing or injecting salt water.