

STATE CORPORATION COMMISSION OF KANSAS
OIL & GAS CONSERVATION DIVISION

WELL COMPLETION OR RECOMPLETION FORM
ACO-1 WELL HISTORY

DESCRIPTION OF WELL AND LEASE

Operator: license # 4289
name NORMAN R. HAMM
address BOX 17
City/State/Zip PERRY, KANSAS 66073

Operator Contact Person N. RODNEY HAMM
Phone 913-597-5111

Contractor: license # 6792
name CANEY VALLEY DRILLING INC.

Wellsite Geologist STEVE NORDENG
Phone 913-841-6181

Designate Type of Completion
 New Well Re-Entry Workover
 Oil SWD Temp Abd
 Gas Inj Delayed Comp.
 Dry Other (Core, Water Supply etc.)

If OWWO: old well info as follows:
Operator
Well Name
Comp. Date Old Total Depth

WELL HISTORY

Drilling Method: Mud Rotary Air Rotary Cable
9-26-85 10-1-85 PLUGGED 10-2-85
Spud Date Date Reached TD Completion Date

1640
Total Depth PBDT

Amount of Surface Pipe Set and Cemented at 86 feet

Multiple Stage Cementing Collar Used? Yes No

If Yes, Show Depth Set feet

If alternate 2 completion, cement circulated
from feet depth to w/ SX cmt

API NO. 15-087-20,207-00-00

County JEFFERSON

NW... NW... Sec 1... Twp 10... Rge 19... East West

1980... Ft North from Southeast Corner of Section
4620... Ft West from Southeast Corner of Section
(Note: locate well in section plat below)


Lease Name LUKENS Well# 1

Field Name MCGLOUTH WILDCAT

Producing Formation NONE

Elevation: Ground 1040 KB

Section Plat

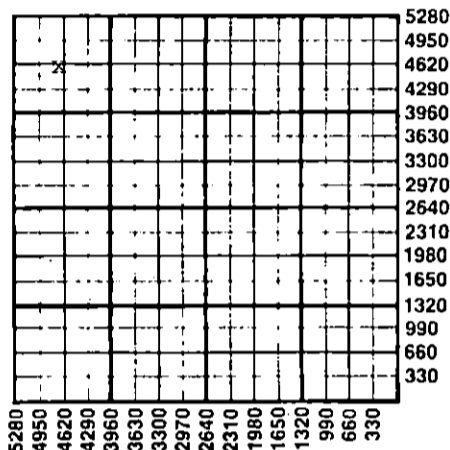

WATER SUPPLY INFORMATION

Source of Water:
Division of Water Resources Permit #

Groundwater... Ft North From Southeast Corner and
(Well) ... Ft. West From Southeast Corner of
Sec Twp Rge East West

Surface Water... Ft North From Southeast Corner and
(Stream, Pond etc.) ... Ft West From Southeast Corner
Sec Twp Rge East West

Other (explain)
(purchased from city, R.W.D.#)

Disposition of Produced Water: Disposal Repressuring

Docket #

INSTRUCTIONS: This form shall be completed in duplicate and filed with the Kansas Corporation Commission, 200 Colorado Derby Building, Wichita, Kansas 67202, within 90 days after completion or recompletion of any well. Rules 82-3-130 and 82-3-107 apply.

Information on side two of this form will be held confidential for a period of 12 months if requested in writing and submitted with the form. See rule 82-3-107 for confidentiality in excess of 12 months.

One copy of all wireline logs and drillers time log shall be attached with this form. Submit CP-4 form with all plugged wells. Submit CP-111 form with all temporarily abandoned wells.

All requirements of the statutes, rules, and regulations promulgated to regulate the oil and gas industry have been fully complied with and the statements herein are complete and correct to the best of my knowledge.

Signature Allan L. Smith
ALLAN L. SMITH BUSINESS MANAGER
Date 10-3-85

Subscribed and sworn to before me this 3rd day of October 1985
Notary Public Linda L. Ewin
Date Commission Expires June 16, 1986

K.C.C. OFFICE USE ONLY
F Letter of Confidentiality Attached
C Wireline Log Received
C Drillers Timelog Received
Distribution
 KCC SWD/Rep NGPA
 KGS Plug Other (Specify)

OCT 7 1985
10-7-85
CONSERVATION DIVISION
Wichita Kansas

Form ACO-1
(This form supercedes previous forms ACO-1 & C-10)

Sec 1
Twp 10
Rge 19E

SIDE TWO

Operator Name NORMAN: R...HAMM..... Lease Name LUKENS..... Well# 1... SEC 1... TWP. 10... RGE. 19... East West

WELL LOG

INSTRUCTIONS: Show important tops and base of formations penetrated. Detail all cores. Report all drill stem tests giving interval tested, time tool open and closed, flowing and shut-in pressures, whether shut-in pressure reached static level, hydrostatic pressures, bottom hole temperature, fluid recovery, and flow rates if gas to surface during test. Attach extra sheet if more space is needed. Attach copy of log.

Drill Stem Tests Taken Yes No
 Samples Sent to Geological Survey Yes No
 Cores Taken Yes No

Formation Description
 Log Sample

| Name | Top | Bottom |
|---------------|------|--------|
| B/KC | | 887 |
| MARM | 1000 | |
| CHEROKEE | 1120 | |
| SQUIRREL SAND | 1128 | 1136 |
| MCLOUTH | 1572 | 1576 |
| BURGESS | 1604 | |
| MISSISSIPPI | 1614 | |
| T.D. | 1640 | |

CASING RECORD new used

Report all strings set - conductor, surface, intermediate, production, etc.

| Purpose of string | size hole drilled | size casing set (in O.D.) | weight lbs/ft. | setting depth | type of cement | # sacks used | type and percent additives |
|-------------------|-------------------|---------------------------|----------------|---------------|----------------|--------------|----------------------------|
| SURFACE | 12 1/2 | 8.7/8 | 22 | 86 | Portland | 200sks | |

PERFORATION RECORD

Acid, Fracture, Shot, Cement Squeeze Record

| shots per foot | specify footage of each interval perforated | (amount and kind of material used) | Depth |
|----------------|---|------------------------------------|-------|
| | | | |

TUBING RECORD

size set at packer at Liner Run Yes No

Date of First Production Producing method flowing pumping gas lift Other (explain)

| Estimated Production Per 24 Hours | Oil | Gas | Water | Gas-Oil Ratio | Gravity |
|-----------------------------------|------|-----|-------|---------------|---------|
| | Bbls | MCF | Bbls | CFPB | |
| | | | | | |

METHOD OF COMPLETION

PRODUCTION INTERVAL

Disposition of gas: vented sold used on lease
 open hole perforation other (specify)
 Dually Completed. Commingled