

15-033-00086-0000

STATE OF KANSAS
STATE CORPORATION COMMISSION
Give All Information Completely
Make Required Affidavit
Mail or Deliver Report to:
Conservation Division
State Corporation Commission
212 North Market, Insurance Bldg.
Wichita, Kansas

WELL PLUGGING RECORD

Commanche

County. Sec. 11 Twp. 34S Rge. (E) 20(W)

Location as "NE/CNW&SW" or footage from lines C-NE/4-SW/4

Lease Owner Amerada Petroleum Corporation

Lease Name Ivella Mai Well No. 1

Office Address Box 197, Great Bend, Kansas

Character of Well (completed as Oil, Gas or Dry Hole) Dry Hole

Date well completed 11-23- 19 63

Application for plugging filed 12-2- 19 63

Application for plugging approved 11-27- 19 63


Plugging commenced 10:30 a.m. 11-24- 19 63

Plugging completed 12 Noon 11-24- 19 63

Reason for abandonment of well or producing formation Dry Hole

If a producing well is abandoned, date of last production - 19 -

Was permission obtained from the Conservation Division or its agents before plugging was commenced? Yes

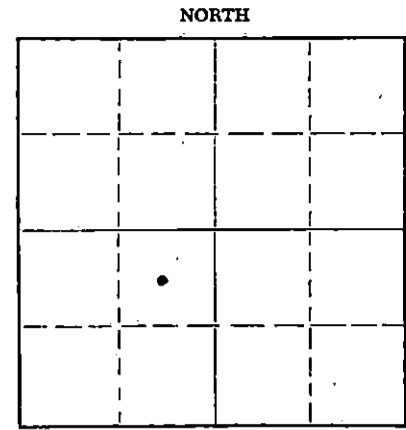

Locate well correctly on above Section Plat

Name of Conservation Agent who supervised plugging of this well Archie Elving, Pratt, Kansas

Producing formation - Depth to top - Bottom - Total Depth of Well 6520 Feet

Show depth and thickness of all water, oil and gas formations.

OIL, GAS OR WATER RECORDS

CASING RECORD

FORMATION	CONTENT	FROM	TO	SIZE	PUT IN	PULLED OUT
				8-5/8" OD	532'	None
				3-3/8" OD	12'	None

Describe in detail the manner in which the well was plugged, indicating where the mud fluid was placed and the method or methods used in introducing it into the hole. If cement or other plugs were used, state the character of same and depth placed, from _____ feet to _____ feet for each plug set.

Filled Hole with Heavy Mud from 6520' to 525' Bridged Hole W/1/4th Sacks Hulls On Top

Spotted Cement Plug By Halliburton 525' to 450' W/25 Sacks Cement

Filled hole with heavy mud from 450' to 40' Bridged Hole W/1/4th Sack Hull

Spotted Cement Plug By Halliburton from 40' to bottom of Cellar W/15 Sacks Cement

RECEIVED
STATE CORPORATION COMMISSION

DEC 4 1963
12-4-63
CONSERVATION DIVISION
Wichita, Kansas

(If additional description is necessary, use BACK of this sheet)

Name of Plugging Contractor Patton Drilling Company

Address 606 Orpheum Bldg., Wichita, Kansas

STATE OF Kansas COUNTY OF Barton, ss.
C.E. Richardson

(employee of owner) or (owner/operator) of the above-described well, being first duly sworn on oath, says: That I have knowledge of the facts, statements, and matters herein contained and the log of the above-described well as filed and that the same are true and correct. So help me God.

(Signature) C.E. Richardson

Box 197, Great Bend, Kansas

(Address)

SUBSCRIBED AND SWORN TO before me this 2nd day of December, 19 63

My commission expires November 21, 1965.

Charles W. Anderson
Charles W. Anderson

Notary Public.

Amerada Petroleum Corporation
Luella Mai Well #1
Total Depth
Comm
Rotary Comp.
Contractor
Patton Drilling Company, Inc.

6520'
10/17/63
11/24/63

Location NE SW Section 11-34S-R20W
Comanche County, Kansas.
CASING RECORD
8 5/8" Casing at 531 Feet
Cemented with 250 Sax Bottom
10 Sax thru 1" on Top

Measurements from Rotary Bushing
10' Rotary Bushing to Ground Level

Red Bed	150
Sand & Shale	187
Dry Drill	533
Red Bed & Sand	670
Red Bed Gyp Shells	1280
Red & Shale	1450
Shaled Shells	1688
Shale & Lime Stks.	1904
Anhydrite & Shale	2060
Lime & Shale	2265
Lime W/Shale & Some Dolemite	2409
Lime & Shale w/chert	2450
Lime & Shale	2550
Sandy Lime	2623
Lime & Shale	2820
Sand & Shale	2930
Shale & Shells	3145
Shale & Chalkey Lime	3270
Shale W/Sand Stks	3475
Lime & Shale	3615
Lime & Sandy Shale	3712
Lime & Shale 3982	3982
Shale & Sand	4075
Shale	4100
Lime & Shale	4348
Lime	4715
Shale Sand & Lime	4763
Lime	4775
Shale Sand & Lime	4800
Lime	4871
Lime & Sandy Shale	4899
Lime & Shale 5151	5151
Lime	5320
Lime W/Chert Stks	5363
Lime	5535
Chalkey Lime & Shale	5573
Lime	5722
Lime & Shale	5762
Lime	5786
Lime W/Chert	5793
Lime Dol & Chert	5816

Lime	5819
Lime, Chert, Sdy Shale	5844
Lime	5891
Cherty Lime " "	5903
Lime Sandy Shale	5942
Lime	5954
Lime & Sandy Shale	5987
Lime & Shale	6002
Lime	6062
Lime & Shale	6129
Lime & Shert	6164
Lime 6214	6214
Cherty Lime	6226
Lime	6268
Cherty Lime	6298
Lime & Sand	6343
Lime	6360
Lime & Shale Stks	6432
Lime & Shale	6478
Lime	6520
Total Depth	6520

RECEIVED
STATE CORPORATION COMMISSION

DEC 13 1963
12-13-63
CONSERVATION DIVISION
Wichita, Kansas

STATE OF Kansas COUNTY OF Sedgewick ss,

I, the undersigned, being duly sworn, on oath state that the above statement and log is a true and correct record and log of the well drilled at the location above described.

PATTON DRILLING COMPANY, INC.

By Robert W. Patton

Subscribed and sworn to before me this 2th day of December 1963

T. P. Hendrick
T. P. Hendrick Notary Public

My Commission expires Oct. 4th 1964