
STATE OF KANSAS STATE CONSERVATION DIVISION CONSERVATION DIVISION 130 S. MARKET, ROOM 2078 Wichita, Kansas 67202

WELL PLUGGING APPLICATION FORM (PLEASE TYPE FORM AND FILE ONE COPY)

		2.00.00	 `			is well). Thi		e listed for			
wells	drilled since	1967; if no AP	l# was issue	d, indicat	e spud	or completio	n date.		10/2	/ a 1	
WELL OPERATOR V		VESS OIL CORPORATION		KCC LICEN		ENSE#	5030		<i> </i>		
ADDRES	SS	(owner/ 8100 E. 22nd St. N	company name) North, Bldg. 300			CITY	Wichita	(operator's)			
STATE	Kansas	ZIP CO	DDE	67226	CONTA	CT PHONE #	(316) 68	2-1537			
LEASE	Frees		WELL#	#1	SEC.	1_T. <u>17S</u> _I	R. <u>11W</u>	_(East/West)			
	NE NE NW	SPOT LOCATION	/QQQQ		COUNT	Y <u>Barton</u>					
5000	FEET (in exa	ct footage) FROI	MSN (circle o	ne) LINE C	F SECT	ION (NOT Lea	ase Line)				
3045	FEET (in exa	ct footage) FRO	MÊW (circle o	one) LINE (OF SEC	TION (NOT Le	ase Line)				
Check On	e: OIL WELL	X GAS WE	<u></u>	D&A		SWD/ENHR WEL	L <u>X</u>	DOCKET#	D-23,997	7	
CONDU	CTOR CASING	SIZE	SET AT		CEMEN	TED WITH			SACKS		
SURFAC	CE CASING SIZE	8-5/8"	SET AT	274	CEMEN	TED WITH		185	SACKS		
PRODUC	TION CASING SIZI	4-1/2"	SET AT	3403	CEMEN	TED WITH		175	SACKS		
LIST (AL	.L) PERFORATIO	ONS and BRIDGEP	LUG SETS:	3369-70'; 0	IBP 3380	'; 3385-87'; CIBP	3402, 3403	3-07(OH)			
ELEVAT	ION	1918/1923	T.D.	3407	PBTD	3380	ANHYDRITE			696	
		(G.L./K.B.)					(Stone Co	rral Formation)			
CONDITIO	ON OF WELL:	GOOD	POOR		_CASING	ELEAK	<u> </u>	JUNK IN HOLE			
	SED METHOD C	F PLUGGING sx 60/40 Pozmix, 69				sx cement cap, s			point.		
		hulls. Pull on out, to	op off with at leas	t 25 sx. Per	Roger Ro						
		(If additional space									
IS WEL	L LOG ATTA	CHED TO THIS A	APPLICATION	AS REQU	IRED?	YES I	IS ACO-1	FILED?	YES-old	d form	l
If not exp	olain why?				_						
		WELL WILL BE ATIONS OF THE					et. seq. A	ND THE			
		PANY REPRES					OF PLUG	GING OPER	ΔΤΙΩΝΙς	•	
	Casey Coats					PHONE		682-1537		<u>. </u>	
ADDRES	ss	8100 E. 22nd Stre	et North, Bldg. 30	00	_CITY/S1	TATE Wichit	a, KS 6722	6			α.
PLUGGI	NG CONTRACT	OR <u>Mike's</u>	Testing & Salvage	e				KCC LICENS		31529	100
ADDRES	SS	Box 467, Chase K	s			_ PHONE#	(316)	938-2943	(contract		-n
PROPO:	SED DATE AND	HOUR OF PLUGG	ING (If known?)		as soor	ı as possible - 2 ı	months	51AII	E CORPOR	NULLAF	COMMISSIO
PAYMEI	NT OF THE PLU	GGING FEE (K.A.R	:. 82-3-118) WILL	BE GUARA	NTEED B	Y OPERATOR O	R AGENT		SEP	12	2000
DATE:	04/27/2000	AUTHO	RIZED OPERAT	OR/AGENT:		11/2 Has	dra				
					 	 	Signatur	e) (Vical Vical	Arion (ta, Kan	

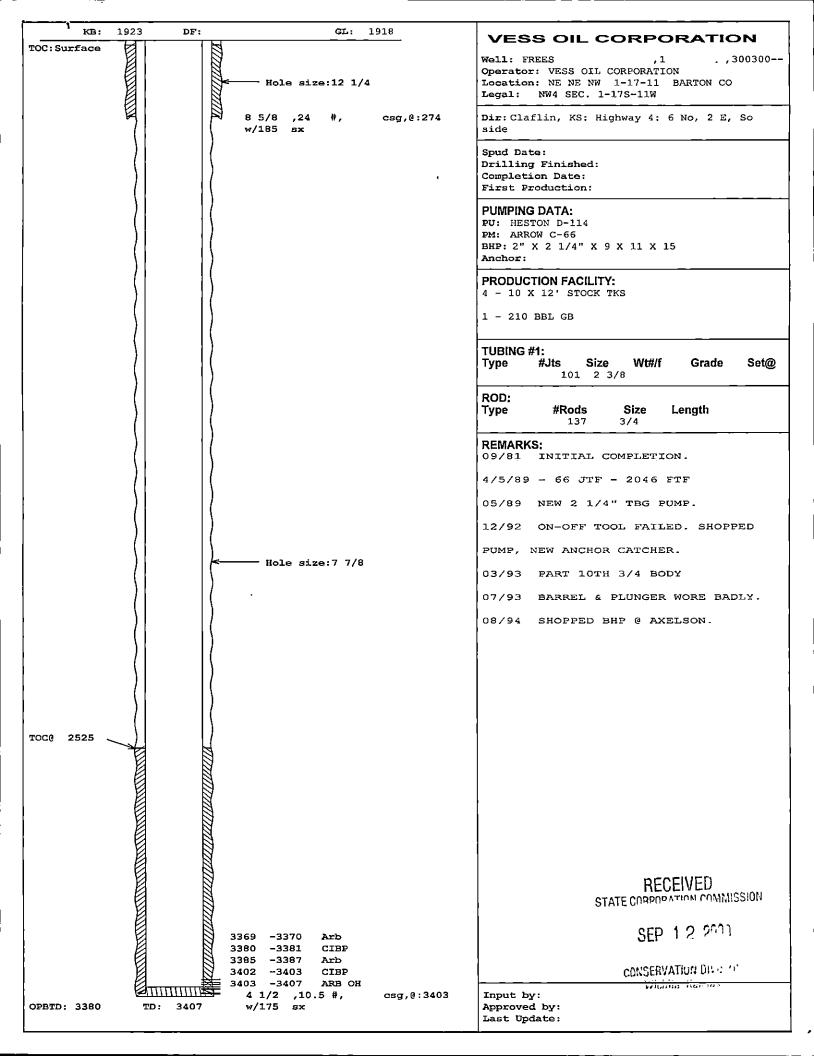



Kansas Corporation Commission

Bill Graves, Governor

John Wine, Chair

Cynthia L. Claus, Commissioner

Brian J. Moline, Commissioner

NOTICE OF RECEIPT OF WELL PLUGGING APPLICATION (CP-1)

Vess Oil Corporation 8100 E. 22nd N. Bldg. 300 Wichita, KS 67226 September 13, 2000

FREES #1 API 15-009-22492-00-00 5000 S 3042 E NE NE NW 1-17S-11W BARTON COUNTY

Dear Casey Coats:

This letter is to notify you that the Conservation Division is in receipt of your plugging proposal, form CP-1, for the above-captioned well.

Your CP-1 has been reviewed by the Conservation Division central office for completeness and to verify license numbers. The plugging proposal will now be forwarded to the district office listed below for review of your proposed method of plugging.

Please contact the district office for approval of your proposed plugging method at least five (5) days before plugging the well, pursuant to K.A.R. 82-3-113 (b). If a workover pit will be used during the plugging of the well it must be permitted. A CDP-1 form must be filed and approved prior to the use of the pit.

The Conservation Division's review of form CP-1, either in the central or district office, does not include an inquiry into well ownership or the filing operator's legal right to plug the well.

This notice in no way constitutes authorization to plug the above-captioned well by persons not having legal rights of ownership or interest in the well. This notice is void after ninety (90) days from the above date.

-Sincerely

David P. Williams

Production Supervisor

District: #4 2301 E. 13th Hays, KS 67601 (785) 625-0550