

15-151-01190-DD-DD


STATE OF KANSAS  
STATE CORPORATION COMMISSION

WELL PLUGGING RECORD

Give All Information Completely  
Make Required Affidavit  
Mail or Deliver Report to  
Conservation Division  
State Corporation Comm.  
245 North Water  
Wichita, KS 67202

Pratt County, Sec. 28 Twp. 26S Rge. 13 NE/W  
Location as "NE/CNW $\frac{1}{4}$ SW $\frac{1}{4}$ " or footage from lines C NW NE

Lease Owner W. K. Black, Inc.  
Lease Name Pattinson Well No. #1  
Office Address P.O. Box 801  
Character of Well (Completed as Oil, Gas or Dry Hole) Abandoned  
Date Well completed 10/28/82 19  
Application for plugging filed 10/28/82 19  
Application for plugging approved 10/28/82 19  
Plugging commenced 1:00 A.M. 10/29/82 19  
Plugging completed 2:20 A.M. 10/29/82 19  
Reason for abandonment of well or producing formation lost circulation, crooked hole, junk in hole  
If a producing well is abandoned, date of last production N/A 19

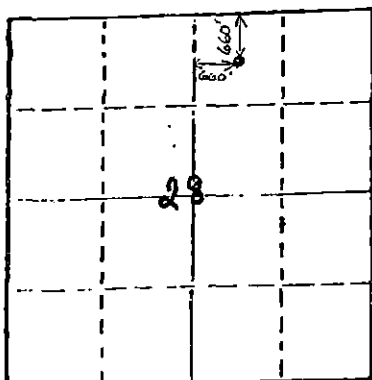

Locate well correctly on above  
Section Plot

Name of Conservation Agent who supervised plugging of this well none  
Producing formation none Depth to top -- Bottom -- Total Depth of Well --  
Show depth and thickness of all water, oil and gas formations.

OIL, GAS OR WATER RECORDS

CASING RECORD

| FORMATION            | CONTENT | FROM    | TO    | SIZE   | PUT IN | PULLED OUT |
|----------------------|---------|---------|-------|--------|--------|------------|
| Red bed, sand, shale |         | surface | 1757' | 8 5/8" | 360'   | No         |
|                      |         |         |       |        |        |            |
|                      |         |         |       |        |        |            |

Describe in detail the manner in which the well was plugged, indicating where the mud fluid was placed and the method or methods used in introducing it into the hold. If cement or other plugs were used, state the character of same and depth placed, from \_\_\_\_\_ feet to \_\_\_\_\_ feet for each plug set.

Mud to 360'. 50 sacks plug mud to 40' solid plug 10 sacks to surface 10 sacks rat hole  
Plug down at 2:20 A.M. 10/29/82

(If additional description is necessary, use BACK of this sheet)

Name of Plugging Contractor Halliburton

STATE OF Kansas COUNTY OF Pratt, ss.


William K. Black (~~any other name of the operator~~)

of the above-described well, being first duly sworn on oath, says: That I have knowledge of the facts, statements, and matters herein contained and the log of the above-described well as filed and that the same are true and correct. So help me God.

(Signature) William K. Black

P.O. Box 801, Pratt, KS 67124-0801  
(Address)

SUBSCRIBED AND SWORN TO before me this 29th day of October, 19 82

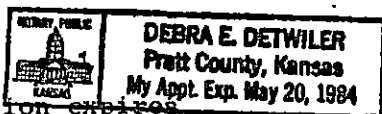

Debra E. Detwiler  
Notary Public.

RECEIVED  
STATE CORPORATION COMMISSION

NOV 1 1982

CONSERVATION DIVISION  
Wichita, Kansas