


WELL PLUGGING RECORD

Give All Information Completely
Make Required Affidavit
Mail or Deliver Report to:
Conservation Division
State Corporation Commission
211 No. Broadway
Wichita, Kansas

Pratt County. Sec. 28 Twp. 26S Rge. 13W (E) (W)

Location as "NE/CNW/SW" or footage from lines W 1/2 SE SW
Lease Owner Monsanto Chemical Company
Lease Name Strait Well No. 7
Office Address P. O. Box 580, Pratt, Kansas
Character of Well (completed as Oil, Gas or Dry Hole) Oil
Date well completed 8-18 19 51
Application for plugging filed 1-2 19 62
Application for plugging approved 1-4 19 62
Plugging commenced 2-6 19 62
Plugging completed 2-15 19 62
Reason for abandonment of well or producing formation Well had reached its economic limit
If a producing well is abandoned, date of last production 4-1 19 61
Was permission obtained from the Conservation Division or its agents before plugging was commenced? Yes

NORTH

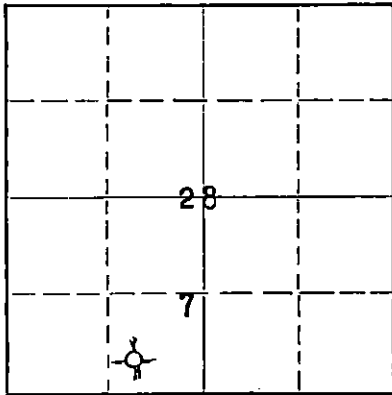

Locate well correctly on above Section Plat

Name of Conservation Agent who supervised plugging of this well Mr. Hampel
Producing formation Mississippi Depth to top 4190' Bottom 4266' Total Depth of Well 4502 Feet
Show depth and thickness of all water, oil and gas formations. PBTD 4326'

OIL, GAS OR WATER RECORDS

CASING RECORD

FORMATION	CONTENT	FROM	TO	SIZE	PUT IN	PULLED OUT
				9-5/8"	867'	0'
				5-1/2"	4482'	3038'

Describe in detail the manner in which the well was plugged, indicating where the mud fluid was placed and the method or methods used in introducing it into the hole. If cement or other plugs were used, state the character of same and depth placed, from _____ feet to _____ feet for each plug set.

Loaded hole with water. Worked and shot 5-1/2" casing free at 3038'. Built rack and slide. Pulled and layed down casing. Bailed down hole. Mudded up to 270' and set 10' rock bridge. Dumped 5 sacks cement. Capped well to top with ready-mixed cement.

RECEIVED
STATE CORPORATION COMMISSION

FEB 23 1962

CONSERVATION DIVISION
Wichita, Kansas

(If additional description is necessary, use BACK of this sheet)
Name of Plugging Contractor Forbes Casing Pulling, Inc.
Address P. O. Box 221, Great Bend, Kansas

STATE OF KANSAS, COUNTY OF PRA TT, ss.
Bruce E. Roll (employee of owner) or (owner or operator) of the above-described

well, being first duly sworn on oath, says: That I have knowledge of the facts, statements, and matters herein contained and the log of the above-described well as filed and that the same are true and correct. So help me God.

(Signature) Bruce E. Roll
Bruce E. Roll
P. O. Box 580, Pratt, Kansas
(Address)

SUBSCRIBED AND SWORN TO before me this 21st day of February, 19 62

Van Doubek
Van Doubek Notary Public.

My commission expires September 4, 1962

DRILLING RECORD

Well No. 7 Strait
W/2 SE/4 SW/4
Sec. 28-26S-13W, Pratt County, Kans.

Casing Record

865' of 9-5/8" OD Surface
pipe cemented with 600 sacks.
4480' of 5 1/2" OD Casing
cemented with 200 sacks.

Work Commenced 7/15/51
Drilling Commenced 7/17/51
Drilling Completed 8/5/51
Work Completed 8/6/51

WELL LOG

Surface	40 to 40
Clay & Sand	40 to 130
Sand	130 to 210
Sand & Red Bed	210 to 415
Shale & Shells	415 to 615
Red Bed, Sand, Shale & Shells	615 to 825
Shale & Shells	825 to 1300
Shale & Red Bed	1300 to 1450
Shale & Shells	1450 to 1600
Shale & Lime	1600 to 2770
Shale & Shells	2770 to 2950
Shale & Lime	2950 to 3915
Lime	3915 to 4050
Lime & Shale	4050 to 4165
Lime & Shale & Chert	4165 to 4230
Lime	4230 to 4270
Shale, Lime & Chert	4270 to 4325
Lime & Chert	4325 to 4345
Chert, Lime & Shale	4345 to 4390
Lime & Shale	4390 to 4428
Lime	4428 to 4443
Arbuckle	4443 to 4464
Lime	4464 to 4482 TD

RECORDED
INDEXED
JAN 1962
CONSERVATION DIVISION
Wichita, Kansas