


WELL PLUGGING RECORD

Give All Information Completely
Make Required Affidavit
Mail or Deliver Report to:
Conservation Division
State Corporation Commission
211 No. Broadway
Wichita, Kansas

Pratt County, Sec. 28 Twp. 26S Rge. 13 (X) (1)

NORTH

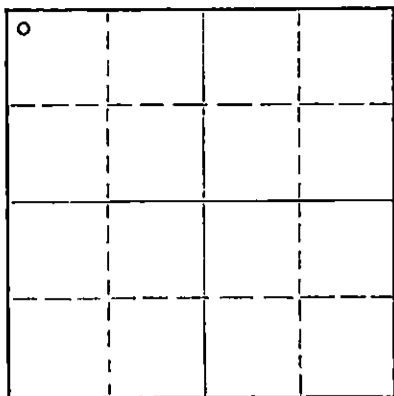

Locate well correctly on above
Section Plat

Location as "NE/CNW%SW%" or footage from lines NW NW NW
Lease Owner Twin Drilling, Inc.
Lease Name Frisbie Well No. 1
Office Address 1005 Central Building, Wichita, Kansas
Character of Well (completed as Oil, Gas or Dry Hole) Dry Hole
Date well completed 6-21 19 58
Application for plugging filed 6-25 19 58
Application for plugging approved 6-25 19 58
Plugging commenced 6-21 19 58
Plugging completed 6-21 19 58
Reason for abandonment of well or producing formation Dry Hole

If a producing well is abandoned, date of last production 19
Was permission obtained from the Conservation Division or its agents before plugging was commenced? Yes

Name of Conservation Agent who supervised plugging of this well Frank Broadfoot, 222 S. Main, St. John, Kansas.
Producing formation _____ Depth to top _____ Bottom _____ Total Depth of Well 4556 Feet
Show depth and thickness of all water, oil and gas formations.

OIL, GAS OR WATER RECORDS

CASING RECORD

FORMATION	CONTENT	FROM -	TO	SIZE	PUT IN	PULLED OUT
				8 5/8"	347.61	None

Describe in detail the manner in which the well was plugged, indicating where the mud fluid was placed and the method or methods used in introducing it into the hole. If cement or other plugs were used, state the character of same and depth placed, from _____ feet to _____ feet for each plug set.

Set plug at 240' W/ 1/4 sack hulls, 20 sax cement through
drill pipe. Mud to 35'. Set plug cement W/ 10 sax cement
cap to base of cellar

(If additional description is necessary, use BACK of this sheet)

Name of Plugging Contractor Twin Drilling, Inc.
Address 1005 Central Building, Wichita, Kansas

STATE OF Kansas, COUNTY OF Sedgwick, ss.
Almeda Day (employee of owner) or (owner or operator) of the above-described well, being first duly sworn on oath, says: That I have knowledge of the facts, statements, and matters herein contained and the log of the above-described well as filed and that the same are true and correct. So help me God.

(Signature) Almeda Day
(Address) _____

SUBSCRIBED AND SWORN to before me this 25 day of June, 19 58.

My commission expires 9-29-60

James S. Rider
Notary Public.

RECEIVED
STATE CORPORATION COMMISSION

JUN 28 1958

CONSERVATION DIVISION
Wichita, Kansas

PLUGGING
FILE SEC. 28 T. 26 R. 13W
BOOK PAGE 110 LINE 24

WELL LOG

Well: Frisbie #1 Contractor: Twin Drilling, Inc.
 Location: NW NW NW 1005 Central Building
 Sec. 28-26S-13W Wichita, Kansas
 Pratt County, Kansas Operator: Same
 Elevation: R.B. 1942 Commenced: 6- 9-58
 Completed: 6-21-58
 Casing: 8 5/8" Surface 347.61'
 W/225 Sax Cement

Sand 134
 Shale - Red Bed 223
 Shale-Shells 315
 Shale 1000
 Shale-Lime Shells 1205
 Shale-Shells 1525
 Shale 1800
 Lime-Shale 1990
 Lime 2360
 Lime-Shale 3087
 Lime W/Shale Bks 3300
 Lime-Shale 3500
 Lime W/Chalk Strks 3641
 Lime-Chalky 3688
 Sand 3808
 Lime 3903
 K.C.Lime-Chert 3937
 Lime 4220
 Lime-Shale 4315
 Lime 4327
 Shale-Chert 4372
 Lime-Chert-Shale 4403
 Viola Lime-Chert 4431
 Lime-Sand 4463
 Sand-Shale 4525
 Sandy Dol. Shale 4533
 Arb. Lime 4556

Tops
 Heebner 3632
 Brown Lime 3799
 Lansing 3818
 Mississippi 4290
 Viola 4389
 Simpson Shale 4432
 Simpson Sand 4434
 Arbuckle 4524

T.D. 4556'

STATE OF KANSAS)
) ss.
 COUNTY OF SEDGWICK)

The undersigned, TWIN DRILLING, INC., hereby certifies that the above log is a true and correct log of the formations encountered in drilling the above well as reflected by the Daily Drilling Report.

TWIN DRILLING, INC.

By: Almeda Day

Subscribed and sworn to before me this 25th day of June, 1958.

James A. Hicks
 Notary Public

My commission expires September 29, 1960.

RECEIVED
 STATE CORPORATION COMMISSION

JUN 28 1958

CONSERVATION DIVISION
 Wichita, Kansas

PLUGGING
 FILE SEC. 28 T. 26 R. 13W
 BOOK PAGE 110 LINE 24