


WELL PLUGGING RECORD

Give All Information Completely
Make Required Affidavit
Mail or Deliver Report to:
Conservation Division
State Corporation Commission
212 North Market, Insurance Bldg.
Wichita, Kansas

Pratt County. Sec. 28 Twp. 26S Rge. 13W (X) (Y)

Location as "NE/CNW&SW" or footage from lines SE SE SW
Lease Owner Monsanto Chemical Company
Lease Name Strait Well No. 4
Office Address P. O. Box 580, Pratt, Kansas
Character of Well (completed as Oil, Gas or Dry Hole) Oil
Date well completed 5-28 19 51
Application for plugging filed 1-2 19 62
Application for plugging approved 1-4 19 62
Plugging commenced 1-31 19 62
Plugging completed 2-5 19 62
Reason for abandonment of well or producing formation Well had reached its economic limit.

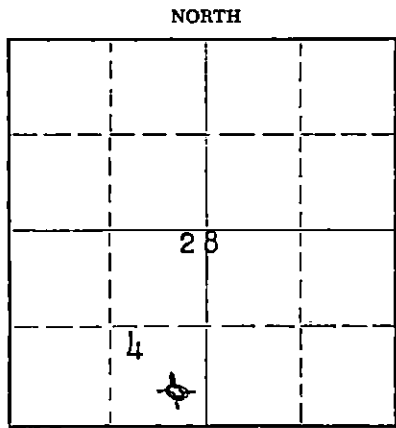

Locate well correctly on above Section Plat

If a producing well is abandoned, date of last production 9-1 19 59

Was permission obtained from the Conservation Division or its agents before plugging was commenced? Yes

Name of Conservation Agent who supervised plugging of this well Mr. Hampel
Producing formation Viola Depth to top 4290' Bottom 4306' Total Depth of Well 4420' Feet
Show depth and thickness of all water, oil and gas formations. PBTD 4310'

OIL, GAS OR WATER RECORDS

CASING RECORD

FORMATION	CONTENT	FROM	TO	SIZE	PUT IN	PULLED OUT
				8-5/8"	832'	0'
				5-1/2"	4408'	2025'

Describe in detail the manner in which the well was plugged, indicating where the mud fluid was placed and the method or methods used in introducing it into the hole. If cement or other plugs were used, state the character of same and depth placed, from _____ feet to _____ feet for each plug set.

Sanded back to 4270' and dumped 5 sacks cement. Worked and shot 5-1/2" casing free at 2025'. Built rack and slide. Pulled and layed down casing. Bailed down hole. Mudded up to 270' and set 10' rock bridge. Dumped 5 sacks cement. Capped the well to top with ready-mixed cement.

RECEIVED
STATE CORPORATION COMMISSION

FEB 23 1962

CONSERVATION DIVISION
Wichita, Kansas

Name of Plugging Contractor Forbes Dasing Pulling, Inc.
Address Box 221, Great Bend, Kansas

STATE OF KANSAS, COUNTY OF PRATT, ss.
Bruce E. Roll (employee of owner) or (owner or operator) of the above-described well, being first duly sworn on oath, says: That I have knowledge of the facts, statements, and matters herein contained and the log of the above-described well as filed and that the same are true and correct. So help me God.

(Signature) Bruce E. Roll
P.O. Box 580, Pratt, Kansas
(Address)

SUBSCRIBED AND SWORN TO before me this 21st day of February, 19 62

My commission expires September 4, 1962

Van Doubek
Notary Public.



STRAIT WELL No. 4

SE SE SW
SEC. 28-26S-13W
PRATT COUNTY,
KANSAS

CONTRACTOR: THE R. W. RINE DRILLING COMPANY
STARTED: MAY 8, 1951

FINISHED: MAY 21, 1951

LOG

SURFACE CLAY	0	520	
SHALE AND RED BED	520	830	Syfo @ 830' - O.K.
ANHYDRITE	830	850	8-5/8" Csg. @ 832' w/ 500 Sx.
SAND AND SHALE	850	1550	
SHALE, SHELLS	1550	1825	
LIME	1825	1915	
LIME AND SHALE	1915	2130	
SAND AND LIME	2130	2260	Syfo @ 2500' - 1/2°.
LIME AND SHALE	2260	2730	
SHALE	2730	3060	Syfo @ 3000' - O.K.
SHALE AND LIME	3060	3530	Syfo @ 3500' - 1°.
LIME	3530	4070	
LIME AND SHALE	4070	4178	
CHERTY LIME	4178	4205	
LIME AND CHERT	4205	4320	
LIME AND SAND	4320	4414	T.D. 5 1/2" Csg. @ 4408' w/ 200 Sx.

STATE OF KANSAS

COUNTY OF SEDGWICK

I, E. H. SLOYER, DO HEREBY CERTIFY THAT THE ABOVE IS A TRUE AND ACCURATE LOG OF THE STRAIT WELL No. 4, LOCATED IN THE SE SE SW OF SECTION 28-26S-13W, PRATT COUNTY, KANSAS.

E. H. Sloyer
SECRETARY

SUBSCRIBED TO AND SWORN BEFORE ME THIS 31ST DAY OF MAY, 1951.

R. M. Green
NOTARY PUBLIC

MY COMMISSION EXPIRES DECEMBER 29, 1952.

RECEIVED
STATE COMMISSION
JAN 10 1962
CONSERVATION DIVISION