

STATE OF KANSAS  
STATE CORPORATION COMMISSION

WELL PLUGGING RECORD

Give All Information Completely  
Make Required Affidavit  
Mail or Deliver Report to:  
Conservation Division  
State Corporation Commission  
211 No. Broadway  
Wichita, Kansas

Pratt County. Sec. 28 Twp. 26S Rge. 13W (W)

Location as "NE/CNW%SW%" or footage from lines C W 1/2 SE SE

Lease Owner Monsanto Chemical Company

Lease Name Strait Well No. 3

Office Address P. O. Box 580, Pratt, Kansas

Character of Well (completed as Oil, Gas or Dry Hole) Oil Well

Date well completed 3-22 1951

Application for plugging filed 1-2 1962

Application for plugging approved 1-4 1962


Plugging commenced 1-13 1962

Plugging completed 1-25 1962

Reason for abandonment of well or producing formation Well had reached its economic limit.

If a producing well is abandoned, date of last production 9-1 1961

Was permission obtained from the Conservation Division or its agents before plugging was commenced? Yes

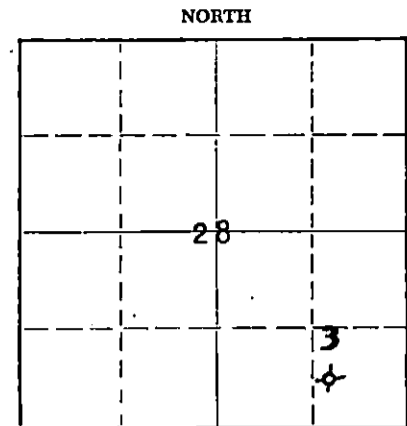

Locate well correctly on above Section Plat

Name of Conservation Agent who supervised plugging of this well Fred Hampel

Producing formation Arbuckle Depth to top 4418 Bottom 4427.5 Total Depth of Well 4427.5 Feet

Show depth and thickness of all water, oil and gas formations. PBTB 4196'

OIL, GAS OR WATER RECORDS

CASING RECORD

FORMATION	CONTENT	FROM	TO	SIZE	PUT IN	PULLED OUT
				8-5/8"	822'	0'
				5-1/2"	4414'	1527'

Describe in detail the manner in which the well was plugged, indicating where the mud fluid was placed and the method or methods used in introducing it into the hole. If cement or other plugs were used, state the character of same and depth placed, from \_\_\_\_\_ feet to \_\_\_\_\_ feet for each plug set.

Sanded back to 3780' and dumped 5 sacks cement.  
Worked and shot casing. Casing parted. Pulled and  
laid down 1,527' of 5-1/2" casing. Bailed down hole.  
Mudded up to 260' and set 10' bridge at 260'. Dumped  
10 sacks cement. Dumped 3-1/2 yards of ready-mixed  
cement to plug top of well.

RECEIVED  
STATE CORPORATION COMMISSION  
FEB 1 1962  
CONSERVATION DIVISION  
Wichita, Kansas

Name of Plugging Contractor Forbes Casing Pulling, Inc.  
Address E. O. Box 221, Great Bend, Kansas

STATE OF Kansas COUNTY OF Pratt, ss.  
Bruce E. Roll (employee of owner) or (owner or operator) of the above-described

well, being first duly sworn on oath, says: That I have knowledge of the facts, statements, and matters herein contained and the log of the above-described well as filed and that the same are true and correct. So help me God.

(Signature) Bruce E. Roll  
Bruce E. Roll  
P. O. Box 580, Pratt, Kansas  
(Address)

SUBSCRIBED AND SWORN to before me this 31st day of January, 1962

My commission expires September 4, 1962

Notary Public



REGISTERED  
 STATE GEOLOGICAL SURVEY  
 JAN 4 1951  
 CONSERVATION DIVISION  
 WICHITA, KANSAS

Strait Well No. 3

Con. W $\frac{1}{2}$  SE $\frac{1}{4}$  SE $\frac{1}{4}$   
 Sec. 28-26S-13W  
 Pratt County, Kansas

Contractor: The R. W. Rine Drilling Company  
 Started: 3/2/51 Finished: 3/17/51

LOG

Sand			
Shale - Red Bed	220 - 675	Syfo @ 400'	-1°
Red Bed	675 - 820		
Anhydrite	820 - 840	Syfo @ 800'	- 1°
Anhydrite & Shale	840 - 980	8-5/8" @ 830'	w/ 500 Sx.
Shale & Shells	980 - 1450		
Shale, Salt, Shells	1450 - 1700	Syfo @ 1500	- O.K.
Shale, Shells, Lime	1700 - 1920		
Shale	1920 - 2000	Syfo @ 2000	- 1/2°
Shale, Lime	2000 - 2150		
Lime	2150 - 2445		
Sandy, Lime - Shale	2445 - 2610	Syfo @ 2500'	- O.K.
Lime & Shale	2610 - 3360		
Sandy Lime	3360 - 3505	Syfo @ 3500	- 1/2°
Lime	3505 - 3595		
Shale & Lime	3595 - 3650		
Sand	3650 - 3692		
Shale & Lime	3692 - 3720		
Lime & Shale	3720 - 3768		
K.C. Lime	3768 - 3815		
Lime	3815 - 4290		
Cherty Lime	4290 - 4310		
Lime, Shale, Sand	4310 - 4350		
Shale	4350 - 4390		
Shale & Lime	4390 - 4420		
Lime	4420 - 4423	T.D. 5 $\frac{1}{2}$ " @ 4422	w/ 200 Sx.

State of Kansas }  
 County of Sedgwick } ss.

I, E. H. Sloyer, do hereby certify that the above is a true and accurate log of the Strait Well No. 3, located in the Con. W $\frac{1}{2}$  SE $\frac{1}{4}$  SE $\frac{1}{4}$  of Section 28-26S-13W, Pratt County, Kansas.

E. H. Sloyer  
 Secretary

Subscribed to and sworn before me this 20th day of March, 1951.

Vin A. McKenzie  
 Notary Public

My Commission Expires September 18, 1952