


STATE OF KANSAS
STATE CORPORATION COMMISSION
Give All Information Completely
Make Required Affidavit
Mail or Deliver Report to:
Conservation Division
State Corporation Commission
212 North Market, Insurance Bldg.
Wichita, Kansas

WELL PLUGGING RECORD

NORTH

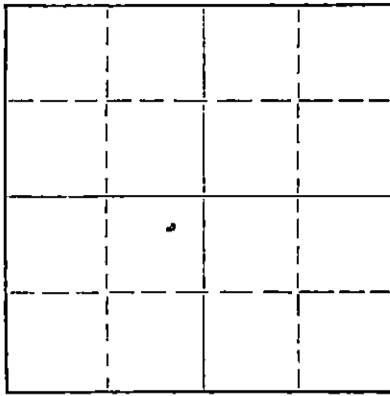

Locate well correctly on above Section Plat

Pratt County. Sec. 28 Twp. 26S Rge. 13W(E) (W)

Location as "NE/CNW/SW" or footage from lines NE/NE/SW

Lease Owner R.W. Rine Drilling Company

Lease Name Reed Well No. #1

Office Address Star Route, Pratt, Kansas Attn: Mr. Roe

Character of Well (completed as Oil, Gas or Dry Hole) Oil

Date well completed 7/24/51 19__

Application for plugging filed Yes 19__

Application for plugging approved Yes 19__

Plugging commenced 9-2 1959

Plugging completed 9-12 1959

Reason for abandonment of well or producing formation _____

If a producing well is abandoned, date of last production 3/7/59 19__

Was permission obtained from the Conservation Division or its agents before plugging was commenced? Yes

Name of Conservation Agent who supervised plugging of this well Mr. La Camp

Producing formation KC Depth to top 3810 Bottom 3818 Total Depth of Well 4533' Feet

Show depth and thickness of all water, oil and gas formations.

OIL, GAS OR WATER RECORDS

CASING RECORD

FORMATION	CONTENT	FROM	TO	SIZE	PUT IN	PULLED OUT
				8 5/8"		
				5 1/2" casing		3,113'

Describe in detail the manner in which the well was plugged, indicating where the mud fluid was placed and the method or methods used in introducing it into the hole. If cement or other plugs were used, state the character of same and depth placed, from _____ feet to _____ feet for each plug set.

Measured into T.D. 4533'.

Plugging started 9-2-59. Finished 9-12-59.

Plugged off bottom and sanded back to 3800'. Dumped 5 sacks of cement.

Worked and shot pipe. Shot 5 1/2" casing at 3,113'. Layed down pipe and plugged well as follows: Mudded to 300'. Set rock bridge and bailed down fluid. Dumped 25 sacks of cement. Filled hole with mud to 35'. Set rock bridge and dumped 10 sacks of cement for cap on well. Cleaned and doped threads on pipe. Well completed.

STATE CORPORATION COMMISSION
SEP 29 1959
CONSERVATION DIVISION
WICHITA, KANSAS

(If additional description is necessary, use BACK of this sheet)
Name of Plugging Contractor J.O. Forbes d/b/a Forbes Casing Pulling Co.
Address Box 221, Great Bend, Kansas

STATE OF Kansas, COUNTY OF Barton, ss.
J.O. Forbes (employee of owner) or (owner or operator) of the above-described well, being first duly sworn on oath, says: That I have knowledge of the facts, statements, and matters herein contained and the log of the above-described well as filed and that the same are true and correct. So help me God.

(Signature) J.O. Forbes
Box 221, Great Bend, Kansas (Address)

SUBSCRIBED AND SWORN to before me this 17th day of September, 1959

My commission expires November 8, 1960.
Netty S. Edman Notary Public.