


WELL PLUGGING RECORD

Give All Information Completely
Make Required Affidavit
Mail or Deliver Report to:
Conservation Division
State Corporation Commission
211 No. Broadway
Wichita, Kansas

Pratt County. Sec. 28 Twp. 26S Rge. 13W (E) (W)

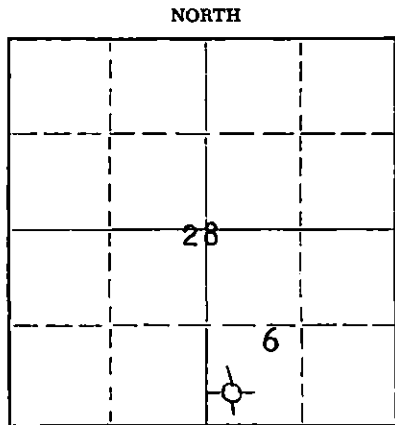

Locate well correctly on above Section Plat

Location as "NE/CNW/SW" or footage from lines SW SW SE
Lease Owner Monsanto Chemical Company
Lease Name Strait Well No. 6
Office Address P. O. Box 580, Pratt, Kansas
Character of Well (completed as Oil, Gas or Dry Hole) Oil
Date well completed 7-9 19 51
Application for plugging filed 1-2 19 62
Application for plugging approved 1-4 19 62
Plugging commenced 1-23 19 62
Plugging completed 2-5 19 62
Reason for abandonment of well or producing formation Well had reached its economic limit.

If a producing well is abandoned, date of last production 5-1 19 59
Was permission obtained from the Conservation Division or its agents before plugging was commenced? Yes

Name of Conservation Agent who supervised plugging of this well Mr. Hampel
Producing formation Viola Depth to top 4292' Bottom 4300' Total Depth of Well 4417' Feet
Show depth and thickness of all water, oil and gas formations. PBTD 4308'

OIL, GAS OR WATER RECORDS

CASING RECORD

FORMATION	CONTENT	FROM	TO	SIZE	PUT IN	PULLED OUT
				9-5/8"	890'	0'
				5-1/2"	4417'	3050'

Describe in detail the manner in which the well was plugged, indicating where the mud fluid was placed and the method or methods used in introducing it into the hole. If cement or other plugs were used, state the character of same and depth placed, from _____ feet to _____ feet for each plug set.

Sanded back to 4280' and dumped 5 sacks cement. Worked and shot 5-1/2" casing free at 3050'. Built rack and slide. Pulled and layed down casing. Bailed down hole. Mudded up to 270' and set 10' rock bridge. Dumped 5 sacks cement. Plugged well to top with approximately 4 yards of ready-mixed cement.

RECEIVED
STATE CORPORATION COMMISSION

FEB 23 1962

CONSERVATION DIVISION
Wichita, Kansas

(If additional description is necessary, use BACK of this sheet)

Name of Plugging Contractor Forbed Casing Pulling, Inc.
Address P. O. Box 221, Great Bend, Kansas

STATE OF KANSAS COUNTY OF PRATT, ss.
Bruce E. Roll (employee of owner) or (owner or operator) of the above-described well, being first duly sworn on oath, says: That I have knowledge of the facts, statements, and matters herein contained and the log of the above-described well as filed and that the same are true and correct. So help me God.

(Signature) Bruce E. Roll
P. O. Box 580, Pratt, Kansas
(Address)

SUBSCRIBED AND SWORN TO before me this 21st day of February, 19 62

My commission expires September 4, 1962 Van Doubek Notary Public.



RECORDED
 STATE GEOLOGICAL COMMISSION
 JAN 4 1962
 CONSERVATION DIVISION
 WICHITA, KANSAS

STRAIT WELL No. 6

SW SW SE
 SEC. 28-26-13W
 PRATT COUNTY, KANSAS

CONTRACTOR: THE R. W. RINE DRILLING COMPANY
 STARTED: JUNE 8, 1951

FINISHED: JUNE 27- 1951

LOG

SOIL CLAY	0	-	40	
SAND, SHALE, RED BED	40	-	725	Syfo @ 400' - O.K.
SHALE	725	-	900	
REAMED	0	-	900	
REAMED	900	-	910	9-5/8 Csg. @ 890 W/520 SX. CEMENT 195# FLOCELE, 67 SX. STRATA CRETE 500# C.C.
CEMENT				RECEMENTED W/250 SX. CEMENT 200# FLOCELE, 2 1/2 SX. C.C.
CEMENT	860	-	910	
SHALE, SHELLS	910	-	1450	Syfo @ 1000' - O.K.
SHALE, SALT	1450	-	1575	Syfo @ 1500' - O.K.
SHALE, SHELLS	1575	-	1860	
LIME AND SHALE	1860	-	2034	
LIME	2034	-	2050	
LIME	2050	-	2155	
SANDY LIME	2155	-	2340	
LIME, SHALE	2340	-	2450	
LIME, SHALE	2450	-	2810	
SHALE	2810	-	2905	Syfo @ 2500' - 3/4"
SHALE, LIME	2905	-	3125	Syfo @ 3000' - 3/4"
SHALE, LIME	3125	-	3330	
LIME	3330	-	3445	
LIME	3445	-	3720	
LIME, SHALE	3720	-	3855	
LIME	3855	-	3945	
LIME	3945	-	4090	
LIME	4090	-	4200	
LIME, CHERT	4200	-	4300	
CHERT, SHALE	4300	-	4330	
SAND	4330	-	4340	
SHALE, SAND	4340	-	4345	
SHALE, SAND	4345	-	4380	
SHALE	4380	-	4411	
LIME	4411	-	4417	5 1/2" csg. @ 4415' W/200 SX.

STATE OF KANSAS }
 COUNTY OF SEDGWICK } ss.

I, R. M. GREEN, DO HEREBY CERTIFY THAT THE ABOVE IS A TRUE AND ACCURATE LOG OF THE STRAIT WELL No. 6, LOCATED SW SW SE OF SECTION 28-26-13W, PRATT COUNTY, KANSAS.

R. M. Green
 ASSISTANT SECRETARY

SUBSCRIBED TO AND SWORN BEFORE ME THIS 7TH DAY OF JULY, 1951.

Leonal Peterson
 NOTARY PUBLIC

MY COMMISSION EXPIRES APRIL 20, 1955.