


WELL PLUGGING RECORD

Give All Information Completely
Make Required Affidavit
Mail or Deliver Report to:
Conservation Division
State Corporation Commission
211 No. Broadway
Wichita, Kansas

Pratt County, Sec. 28 Twp. 26S Rge. 13W (#) (W)

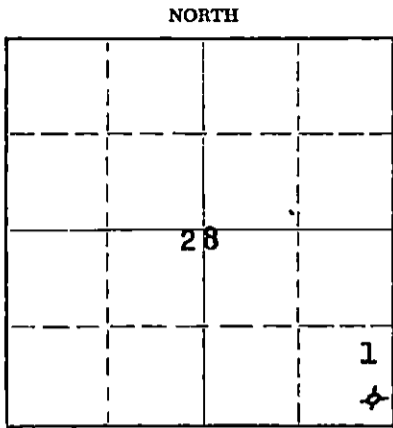

Locate well correctly on above
Section Plat

Location as "NE/CNW/SW" or footage from lines SE SE SE
Lease Owner Monsanto Chemical Company
Lease Name Strait Well No. 1
Office Address P. O. Box 580, Pratt, Kansas
Character of Well (completed as Oil, Gas or Dry Hole) Oil Well
Date well completed 2-11 1951
Application for plugging filed 1-2 1962
Application for plugging approved 1-4 1962
Plugging commenced 1-9 1962
Plugging completed 1-25 1962
Reason for abandonment of well or producing formation Well had reached its economic limit.

If a producing well is abandoned, date of last production 1-1 1959

Was permission obtained from the Conservation Division or its agents before plugging was commenced? Yes

Name of Conservation Agent who supervised plugging of this well Fred Hampel
Producing formation Viola Depth to top 4211 Bottom 4305 Total Depth of Well 4417 Feet
Show depth and thickness of all water, oil and gas formations. PBTD 4301'

OIL, GAS OR WATER RECORDS

CASING RECORD

FORMATION	CONTENT	FROM	TO	SIZE	PUT IN	PULLED OUT
				13-3/8"	250'	0'
				8-5/8"	1002'	0'
				5-1/2"	4391'	3012'

Describe in detail the manner in which the well was plugged, indicating where the mud fluid was placed and the method or methods used in introducing it into the hole. If cement or other plugs were used, state the character of same and depth placed, from _____ feet to _____ feet for each plug set.

Sanded back to 4440' and dumped 5 sacks cement.
Loaded hole with water. Worked and shot 5-1/2"
casing free at 3,012'. Pulled and layed down casing.
Bailed hole down. Mudded up to 250' and set 10' rock
bridge at 250'. Dumped 3-1/2 yards of ready-mixed
cement to plug top of well.

RECEIVED
STATE CORPORATION COMMISSION
FFB 1 1962
CONSERVATION DIVISION
Wichita, Kansas

(If additional description is necessary, use BACK of this sheet)
Name of Plugging Contractor Forbes Casing Pulling, Inc.
Address P. O. Box 221, Great Bend, Kansas

STATE OF Kansas COUNTY OF Pratt, ss.
Bruce E. Roll (employee of owner) or (owner or operator) of the above-described well, being first duly sworn on oath, says: That I have knowledge of the facts, statements, and matters herein contained and the log of the above-described well as filed and that the same are true and correct. So help me God.

(Signature) Bruce E. Roll
Bruce E. Roll
P. O. Box 580, Pratt, Kansas
(Address)

SUBSCRIBED AND SWORN to before me this 31st day of January, 1962

My commission expires September 4, 1962 Van Doubek Notary Public.



KANSAS WELL LOG BUREAU--- KANSAS GEOLOGICAL SOCIETY
 508 EAST MURDOCK - WICHITA, KANSAS

COPY

COMPANY LIO. OIL COMPANY


SEC 28 T. 23 S. 13W
 LOC SE SE SE

WELL SURFIT (JOB #2) NO. 1

DATE 4-17-61
 TIME 10-10-51
 NAME OF OPERATOR
 CONTRACTOR
 DEPTH 3-17-51

DATE 2-21-61

COUNTY Pratt

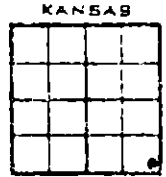

DEPTH 4317
 10 0' w/425 sx
 1530' cem. w/200 sx

ELEVATION

PRODUCTION Estimated 75 bbls. oil

FIGURES INDICATE BOTTOM OF FORMATIONS




Notes:
 Sampled 11 bbls. oil per hr.
 Estimated 75 bbls. oil per day.