

STATE OF KANSAS
STATE CORPORATION COMMISSION

WELL PLUGGING RECORD

Give All Information Completely
Make Required Affidavit
Mail or Deliver Report to
Conservation Division
State Corporation Comm.
245 North Water
Wichita, KS 67202

Comanche County. Sec. 4 Twp. 35S Rge. 16W E/W
Location as "NE/CNW $\frac{1}{4}$ SW $\frac{1}{4}$ " or footage from lines

NE SW SW
Lease Owner Lee Banks
Lease Name McMoran Well No. 1

Office Address 200 W. Douglas, Suite 550, Wichita, KS 67202
Character of Well (Completed as Oil, Gas or Dry Hole)

Dry Hole


Date Well completed January 31, 1981
Application for plugging filed January 31, 1981
Application for plugging approved January 31, 1981
Plugging commenced January 31, 1981
Plugging completed January 31, 1981
Reason for abandonment of well or producing formation

Dry Hole

If a producing well is abandoned, date of last production 19

Was permission obtained from the Conservation Division or its agents before plugging was commenced? Yes

Name of Conservation Agent who supervised plugging of this well Wm. T. Owen
Producing formation Depth to top Bottom Total Depth of Well 5300'
Show depth and thickness of all water, oil and gas formations.

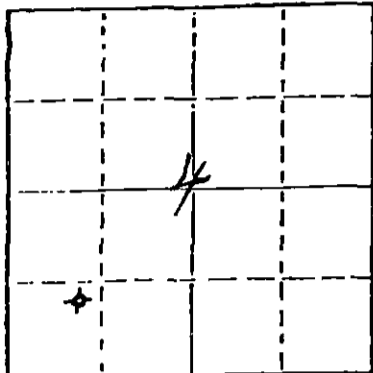

Locate well correctly on above Section Plat

OIL, GAS OR WATER RECORDS

CASING RECORD

FORMATION	CONTENT	FROM	TO	SIZE	PUT IN	PULLED OUT
		0'	407'	8-5/8"	399.26'	None

Describe in detail the manner in which the well was plugged, indicating where the mud fluid was placed and the method or methods used in introducing it into the hold. If cement or other plugs were used, state the character of same and depth placed, from feet to feet for each plug set.


Plugged with 40 sacks cement at 415';
10 sacks cement at 40'; and 15 sacks
cement in rat hole.

(If additional description is necessary, use BACK of this sheet)

Name of Plugging Contractor Allied Cementing Co.

STATE OF KANSAS COUNTY OF SEDGWICK, ss.
John D. Knightley Agent (employee of owner) or (owner or operator)
of the above-described well, being first duly sworn on oath, says: That I have knowledge of the facts, statements, and matters herein contained and the log of the above-described well as filed, and that the same are true and correct. So help me God.

(Signature) [Signature]
221 S. Broadway, Wichita, Kansas 67202
(Address)

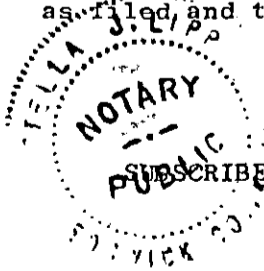

SUBSCRIBED AND SWORN TO before me this 23rd day of February, 1981

[Signature] Notary Public.

My commission expires March 12, 1983

RECEIVED
FEB 26 1981
2-26-81
CONSERVATION DIVISION
Wichita, Kansas

Lee Banks -
 200 W. Douglas, Suite 550
 Wichita, Kansas 67202

McMoran #1-4
 NE SW SW Sec. 4-35S-16W
 Comanche County, Kansas

Contractor: D. R. Lauck Oil Company, Inc.
 221 S. Broadway, Suite 400
 Wichita, Kansas 67202

Commenced: January 18, 1981

Completed: January 31, 1981

Drillers Log

Clay, Gyp & Sand	90
Gyp & Sand	555
Red Bed & Shale	1510
Shale	1740
Shale & Lime	2095
Shale	2320
Shale & Lime	2900
Lime & Shale	3810
Lime	4060
Lime & Shale	4345
Lime	4485
Shale & Lime	4595
Lime	5300 RTD

RECEIVED
 CONSERVATION COMMISSION

FEB 26 1981
 2-26-81
 CONSERVATION DIVISION
 Wichita, Kansas