


Give All Information Completely  
Make Required Affidavit  
Mail or Deliver Report to:  
Conservation Division  
State Corporation Commission  
212 No. Market  
Wichita, Kansas

WELL PLUGGING RECORD

NORTH

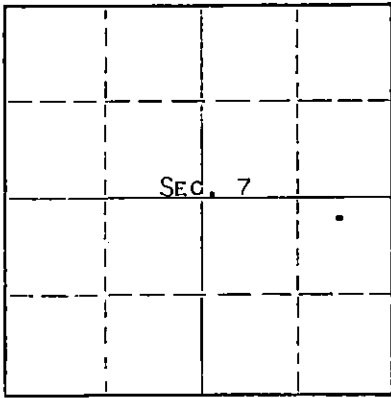

Locate well correctly on above  
Section Plat

COMANCHE County, Sec. 7 Twp. 35S Rge. 16 (EX (W)  
Location as "NE/CNW%SW%" or footage from lines. App. C NE SE  
Lease Owner PETROLEUM, INC.,  
Lease Name BEELEY UNIT Well No. 1  
Office Address R.R. #2, GREAT BEND, KANSAS  
Character of Well (completed as Oil, Gas or Dry Hole) DRY HOLE  
Date well completed MAY 15 19 69  
Application for plugging filed MAY 15 19 69  
Application for plugging approved MAY 15 19 69  
Plugging commenced MAY 15 19 69  
Plugging completed MAY 15 19 69  
Reason for abandonment of well or producing formation NO PRODUCIBLE FORMATION

If a producing well is abandoned, date of last production NONE 19  
Was permission obtained from the Conservation Division or its agents before plugging was commenced? YES

Name of Conservation Agent who supervised plugging of this well R. J. WARREN  
Producing formation \_\_\_\_\_ Depth to top \_\_\_\_\_ Bottom \_\_\_\_\_ Total Depth of Well 6215 Feet  
Show depth and thickness of all water, oil and gas formations.

OIL, GAS OR WATER RECORDS

CASING RECORD

FORMATION	CONTENT	FROM	TO	SIZE	PUT IN	PULLED OUT
				8-5/8"	292'	NONE

Describe in detail the manner in which the well was plugged, indicating where the mud fluid was placed and the method or methods used in introducing it into the hole. If cement or other plugs were used, state the character of same and depth placed, from \_\_\_\_\_ feet to \_\_\_\_\_ feet for each plug set.

HEAVY MUD TO 500', FOLLOWED WITH 70 SACKS CEMENT. HEAVY MUD TO 280', FOLLOWED WITH 40 SACKS CEMENT. HEAVY MUD TO 40', FOLLOWED WITH 20 SACKS OF CEMENT TO BASE OF WELL CELLAR.

RECEIVED  
STATE CORPORATION COMMISSION  
MAY 26 1969  
CONSERVATION DIVISION  
Wichita, Kansas

(If additional description is necessary, use BACK of this sheet)

Name of Plugging Contractor GARVEY DRILLING COMPANY  
Address R.R. #2, GREAT BEND, KANSAS

STATE OF KANSAS, COUNTY OF BARTON, ss.  
LAWRENCE PROFFITT (employee of owner) or (operator) of the above-described well, being first duly sworn on oath, says: That I have knowledge of the facts, statements, and matters herein contained and the log of the above-described well as filed and that the same are true and correct. So help me God. LAWRENCE PROFFITT, DIST. PROD. FOREMAN

(Signature) Lawrence Proffitt  
R.R. #2, GREAT BEND, KANSAS  
(Address)

SUBSCRIBED AND SWORN to before me this 23 day of MAY, 1969

Richard W. Dumble  
Notary Public.

My commission expires MAY 28, 1973

# WELL LOG

COMPANY Petroleum, Inc.

SEC. 7 T. 35S R. 16W

FARM Beeley Unit NO. 1

LOC. C NE SE


TOTAL DEPTH 6215'

COUNTY Comanche, Kansas

COMM. 4-25-69 COMP. 5-15-69

CONTRACTOR Garvey Drilling Company

CASING  
13 3/8" @ 292' w/225sx

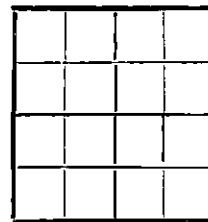

ELEVATION 1904' KB

PRODUCTION D & A

FIGURES INDICATE BOTTOM OF FORMATIONS

- 77' Sand & Red Dirt
- 292' Surface Soils
- 600' Red Bed
- 1600' Shale, Salt, & Anhydrite
- 2039' Red Bed & Shale
- 2202' Shale
- 2465' Shale & Lime
- 2565' Lime
- 2825' Shale & Lime
- 3039' Lime & Shale
- 3681' Shale
- 4710' Lime & Shale
- 4808' Lime
- 6121' Lime & Shale
- 6184' Lime
- 6215' RTD

RECEIVED  
 STATE CORPORATION COMMISSION  
 MAY 26 1969  
 CONSERVATION DIVISION  
 Wichita, Kansas

State of Kansas }  
 County of Barton } ss

I, Charlene Marker of Garvey Drilling Company

upon oath state the above and foregoing is a true and correct copy of the log of the Beeley Unit No. 1 well.

Charlene Marker

Subscribed and sworn to before me this 20th day of May 19 69

My Commission Expires: November 5, 1969

Richard Hoys  
 NOTARY PUBLIC