

STATE OF KANSAS
STATE CORPORATION COMMISSION
CONSERVATION DIVISION
P. O. BOX 17027
WICHITA, KANSAS 67217

FORM CP-4

WELL PLUGGING RECORD

Commanche County, Sec. 7 Twp. 35S Rge. (E) 16 (W)

Location as "NE/CNW&SW" or footage from lines C NW/4

Lease Owner Samson Resources

Lease Name Beeley Well No. #1

Office Address 2700 First Place, Tulsa, Oklahoma 74103

Character of Well (completed as Oil, Gas or Dry Hole) Dry Hole

Date well completed 19 75

Application for plugging filed 7-30 19 75

Application for plugging approved 19


Plugging commenced 7-31 19 75

Plugging completed 8-5 19 75

Reason for abandonment of well or producing formation Dry Hole

If a producing well is abandoned, date of last production 19

Was permission obtained from the Conservation Division or its agents before plugging was commenced? yes

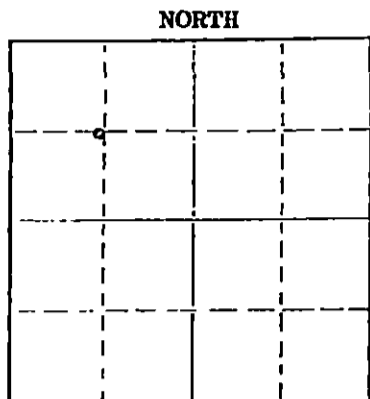

Locate well correctly on above Section Plot

Name of Conservation Agent who supervised plugging of this well G. R. Biberstein

Producing formation Dry Depth to top Bottom Total Depth of Well 6075 Feet

Show depth and thickness of all water, oil and gas formations.

OIL, GAS OR WATER RECORDS

CASING RECORD

FORMATION	CONTENT	FROM	TO	SIZE	PUT IN	PULLED OUT
				4 1/2"	5550'	4734.59'
				13 3/8"	434'	None

Describe in detail the manner in which the well was plugged, indicating where the mud fluid was placed and the method or methods used in introducing it into the hole. If cement or other plugs were used, state the character of same and depth placed, from feet to feet for each plug set.

Spotted 25 sacks cement to 5050', shot at 4705', spotted 2 sacks hulls, 10 sacks gel, and 100 sacks cement from 384' - 484', capped surface with 30 sacks cement 3' - 33', welded on steel plate.

RECEIVED
STATE CORPORATION COMMISSION

AUG 15 1975
813-75
CONSERVATION DIVISION
Wichita, Kansas

(If additional description is necessary, use BACK of this sheet)

Name of Plugging Contractor Lillard Casing Pulling, Inc.

Address P.O. Box 962, Woodward, Oklahoma 73801

STATE OF Oklahoma COUNTY OF Tulsa

Calvin Guthridge

(employee of owner) or (owner or operator) of the above-described

well, being first duly sworn on oath, says: That I have knowledge of the facts, statements, and matters herein contained and the log of the above-described well as filed and that the same are true and correct. So help me God.

(Signature) Calvin Guthridge

2700 First Place, Tulsa, Oklahoma 74103

(Address)

RECORDED AND SWORN TO before me this 12 day of August 19 75

My commission expires May 23, 1978

Opal M. Perry
Opal M. Perry Notary Public