


STATE OF KANSAS
STATE CORPORATION COMMISSION

Give All Information Completely
Make Required Affidavit
Mail or Deliver Report to:
Conservation Division
State Corporation Commission
211 No. Broadway
Wichita, Kansas

WELL PLUGGING RECORD

NORTH

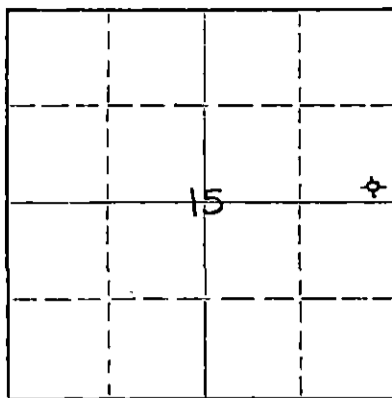

Locate well correctly on above
Section Plat

Pratt

County, Sec. 15 Twp. 26S Rge. 13 (W)

Location as "NE/CNWxSWx" or footage from lines SE SE NE

Lease Owner D. R. Lauck Oil Company, Inc.

Lease Name Shrack Well No. 1

Office Address 301 South Broadway, Wichita 2, Kansas

Character of Well (completed as Oil, Gas or Dry Hole) dry hole

Date well completed November 7 1957

Application for plugging filed November 7 1957

Application for plugging approved November 7 1957

Plugging commenced November 7 1957

Plugging completed November 7 1957

Reason for abandonment of well or producing formation
dry hole

If a producing well is abandoned, date of last production 19

Was permission obtained from the Conservation Division or its agents before plugging was commenced? yes

Name of Conservation Agent who supervised plugging of this well M. A. Rives

Producing formation Depth to top Bottom Total Depth of Well 11485 Feet

Show depth and thickness of all water, oil and gas formations.

OIL, GAS OR WATER RECORDS

CASING RECORD

FORMATION	CONTENT	FROM	TO	SIZE	PUT IN	PULLED OUT
		0	256	8 5/8"	256	none

Describe in detail the manner in which the well was plugged, indicating where the mud fluid was placed and the method or methods used in introducing it into the hole. If cement or other plugs were used, state the character of same and depth placed, from feet to feet for each plug set.

hole filled with mud 11485 - 250
 plug 250 - 246
 part sack hulls & cement 246 - 40
 mud & part sack hulls 40 - 35
 plug 35 - 31
 cement 31 - 6 bottom of cellar

RECEIVED
STATE CORPORATION COMMISSION

APR 16 1958

CONSERVATION DIVISION
Wichita, Kansas

(If additional description is necessary, use BACK of this sheet)

Name of Plugging Contractor Globe Cementing Company

Address Great Bend, Kansas

STATE OF Kansas, COUNTY OF Sedgwick, ss.

John H. Knightley (employee of owner) or (owner or operator) of the above-described well, being first duly sworn on oath, says: That I have knowledge of the facts, statements, and matters herein contained and the log of the above-described well as filed and that the same are true and correct. So help me God.

(Signature) John H. Knightley
Wichita Kansas
(Address)

SUBSCRIBED AND SWORN TO before me this 15 day of April, 19 58

My commission expires Sept. 14, 1959

Elizabet Gay
Notary Public.

PLUGGING
FILE SEC 15 T. 26 R. 13a
BOOK PAGE 60 LINE 31

D. R. Lauck Oil Company, Inc.

SE SE NE Sec.15- 26S-13W
Pratt County, Kansas

Shrack #1

Commenced: October 24, 1957
Completed: November 7, 1957

Casing Record: 256' 8 5/8" cem.w/225 sax

Elevation: GR 1915; DF 1917; KB 1919;

Drillers Log

Sand	160
Red bed	445
sand	480
shale & shells	780
Anhydrite	820
shale & shells	1700
lime & shale	2575
shale & shells	2760
shale & lime	3360
lime (broken)	3460
broken lime & shale	3560
Lime & shale	3670
Douglas (shale & Lime)	3705
lime	4028
lime & shale	4080
Lime	4119
lime & chert	4205
shale & chert	4214
chert	4235
lime, shale & chert	4270
lime & chert	4306
lime, shale & chert	4315
sand	4343
shale & lime	4380
Arbuckle Lime	4485

		Tops
Heebner	3542-1623	3541-1622
Toronto	3564-1645	3562-1643
Douglas	3578-1659	3576-1657
Brown lime	3706-1787	3706-1787
Lansing Kansas City	3724-1805	3723-1804
Base Kansas City	4049-2130	4044-2125
Mississippian	4164-2245	4160-2241
Kinderhook	4198-2279	4198-2275
Viola	4262-2343	4267-2348
Simpson shale	4304-2385	4302-2383
Simpson sand	4316-2397	4316-2397
Arbuckle	4380-2461	4373-2454
Rotary Total Depth	4485-2566	4483-2564

DST #1 (M-D) 4165-4180 open 1 hr.strong blow
1 hr. gas to surface 12 min.,
insufficient to gauge.
Recov. 50' gas cut mud; IFP 40#
FFP 40# BHP 1140#,20 min.

DST #2 (W) 4316-4328 open 1 hr.weak blow 1 hr;
recov.30' mud IFP 0# BHP 0# in
20 min.

DST #3 (4268-4288)(straddle test w/Halliburton
Acid Tool) open 1½ hrs. strong blow
initially,due to acid gas,gradually
declining to nothing at end of 1½
hr period. Recov. 58' acid water;
IFP 54#; FFP 54# BHP 54# in
20 min.

D & A

RECEIVED
COMMISSION

NOV 10 1957

DIVISION
Pratt, Kansas

PLUGGING
NO 15 T 26 R 13 W
BOOK PAGE 60 LINE 31