

STATE OF KANSAS
STATE CORPORATION COMMISSION

Give All Information Completely
Make Required Affidavit
Mail or Deliver Report to:
Conservation Division
State Corporation Commission
211 No. Broadway
Wichita, Kansas

WELL PLUGGING RECORD

Pratt County, Sec. 16 Twp. 26S Rge. (E) 13 (W)

Location as "NE/CNW/SW" or footage from lines NW NE

Lease Owner Tenneco Oil Company

Lease Name Phyllis Kipp Shrack "A" Well No. 1

Office Address 2000 Classen Bldg., Oklahoma City, Okla.

Character of Well (completed as Oil, Gas or Dry Hole) Dry Hole

Date well completed 4-8 19 66

Application for plugging filed 4-13 19 66

Application for plugging approved 4-12 19 66


Plugging commenced 4-7 19 66

Plugging completed 4-7 19 66

Reason for abandonment of well or producing formation Dry

If a producing well is abandoned, date of last production 19

Was permission obtained from the Conservation Division or its agents before plugging was commenced? Yes

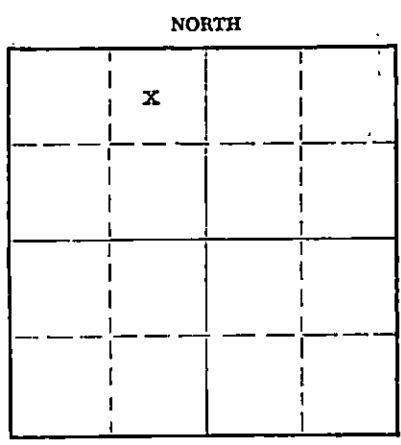

Locate well correctly on above Section Plat

Name of Conservation Agent who supervised plugging of this well

Producing formation None g Depth to top Bottom Total Depth of Well 3898 Feet

Show depth and thickness of all water, oil and gas formations.

OIL, GAS OR WATER RECORDS

CASING RECORD

FORMATION	CONTENT	FROM	TO	SIZE	PUT IN	PULLED OUT
				8-5/8	320'	-0-

Describe in detail the manner in which the well was plugged, indicating where the mud fluid was placed and the method or methods used in introducing it into the hole. If cement or other plugs were used, state the character of same and depth placed, from feet to feet for each plug set.

Filled hole with mud to 275'. Set plug with 1/4 sk. hulls and 25 sks. of cement, mudded to 40', set plug with 1/4 sk. hulls and 10 skx. of cement to top.

2 sacks cement in rat hole.

RECEIVED
STATE CORPORATION COMMISSION

APR 25 1966

CONSERVATION DIVISION
Wichita, Kansas

(If additional description is necessary, use BACK of this sheet)

Name of Plugging Contractor Burch Exploration, Inc.

Address 1011 Union Center Building, Wichita, Kansas

STATE OF OKLAHOMA, COUNTY OF OKLAHOMA, ss.

(employee of owner) or (owner or operator) of the above-described well, being first duly sworn on oath, says: That I have knowledge of the facts, statements, and matters herein contained and the log of the above-described well as filed and that the same are true and correct. So help me God.

(Signature) John G. Lemons, District Office Supv.
2000 Classen Building, Oklahoma City, Okla.
(Address)

SUBSCRIBED AND SWORN to before me this 22nd day of April, 1966

My commission expires 3/14/70

Patricia Bruce
Notary Public.

CONTRACTOR'S
WELL LOG

Tenneco Oil Company &
Burch Exploration, Inc.
#1 Shrack "A"
NW NE Sec. 15-26S-13W
Pratt County, Kansas

Set 8-5/8" @ 309'
Commenced: 3-30-66
Completed: 4-7-66
Elevation: 1928 KB
D & A

160 Sand & Gravel
1105 Red Bed
1450 Shale & Shells
3805 Lime & Shale
3898 Lime

3898 Rotary Total Depth

Tops

Heebner	3587 (-1659)
Toronto	3606 (-1678)
Douglas	3626 (-1688)
Douglas Sand	3649 (-1721)
Brown Lime	3753 (-1825)
Lansing	3783 (-1855)

STATE OF KANSAS)
) ss:
COUNTY OF SEDGWICK)

RECEIVED
STATE CORPORATION COMMISSION


APR 25 1966

CONSERVATION DIVISION
Wichita, Kansas

I, Earl M. Burch, President of Burch Exploration, Inc. being duly sworn on oath, state: That I have knowledge of the facts, statements and matters herein contained and that the same are true and correct.


Earl M. Burch, President

Subscribed and sworn to before me this 18th day of March, 1966.

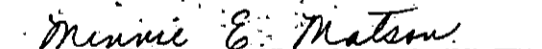
Minnie E. Matson, Notary Public

My commission expires: June 18, 1968