

STATE OF KANSAS  
STATE CORPORATION COMMISSION

WELL PLUGGING RECORD

Give All Information Completely  
Make Required Affidavit  
Mail or Deliver Report to:  
Conservation Division  
State Corporation Commission  
211 No. Broadway  
Wichita, Kansas

Pratt

County. Sec. 28 Twp. 26S Rge. 13W (E) (W)

Location as "NE/CNW/SW" or footage from lines N<sup>1</sup>/<sub>2</sub> SW SE

Lease Owner Monsanto Chemical Company

Lease Name Strait Well No. 9

Office Address P. O. Box 580, Pratt, Kansas

Character of Well (completed as Oil, Gas or Dry Hole) Oil

Date well completed 6-9 19 52

Application for plugging filed 1-2 19 62

Application for plugging approved 1-4 19 62


Plugging commenced 2-10 19 62

Plugging completed 2-15 19 62

Reason for abandonment of well or producing formation Well had reached its economic limit

If a producing well is abandoned, date of last production 7-10 19 61

Was permission obtained from the Conservation Division or its agents before plugging was commenced? Yes

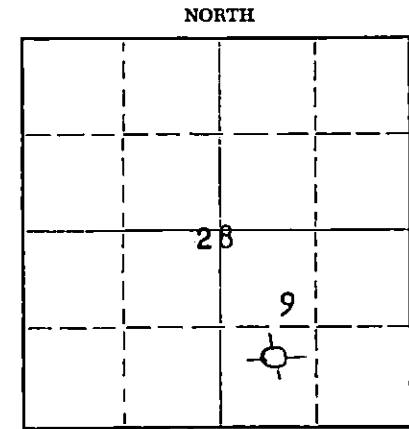

Locate well correctly on above Section Plat

Name of Conservation Agent who supervised plugging of this well Mr. Hampel

Producing formation Mississippi Depth to top 4244' Bottom 4252' Total Depth of Well 4305 Feet

Show depth and thickness of all water, oil and gas formations. PBTD 4262'

OIL, GAS OR WATER RECORDS

CASING RECORD

FORMATION	CONTENT	FROM	TO	SIZE	PUT IN	PULLED OUT
				8-5/8"	868'	0'
				5-1/2"	4299'	3061'

Describe in detail the manner in which the well was plugged, indicating where the mud fluid was placed and the method or methods used in introducing it into the hole. If cement or other plugs were used, state the character of same and depth placed, from \_\_\_\_\_ feet to \_\_\_\_\_ feet for each plug set.

Sanded back to 4224' and dumped 5 sacks cement.

Loaded hole with water. Worked and shot 5-1/2" casing free at 3061'. Built rack and slide. Pulled and layed down casing.

Bailed down hole. Mudded up to 260' and set 10' rock bridge. Dumped 5 sacks cement.

Plugged well to top with ready-mixed cement.

RECEIVED  
STATE CORPORATION COMMISSION  
FEB 20 1962  
CONSERVATION DIVISION  
Wichita, Kansas

(If additional description is necessary, use BACK of this sheet)

Name of Plugging Contractor Forbes Casing Pulling, Inc.

Address P. O. Box 221, Great Bend, Kansas

STATE OF KANSAS, COUNTY OF PRATT, ss.  
Bruce E. Roll (employee of owner) or (owner or operator) of the above-described

well, being first duly sworn on oath, says: That I have knowledge of the facts, statements, and matters herein contained and the log of the above-described well as filed and that the same are true and correct. So help me God.

(Signature) Bruce E. Roll  
Bruce E. Roll  
P. O. Box 580, Pratt, Kansas  
(Address)

SUBSCRIBED AND SWORN to before me this 21st day of February, 19 62

Van Doubek  
Notary Public.

My commission expires September 4, 1962



STRAIT WELL No. 9

CTR. N $\frac{1}{2}$  SW $\frac{1}{4}$  SEC  
SECTION 23-26S-13W  
PRATT COUNTY, KANSAS

CONTRACTOR: THE R. W. RINE DRILLING COMPANY

STARTED: MAY 12, 1952

FINISHED: MAY 31, 1952

LOG

CONSERVATION DIVISION  
Wichita, Kansas

CLAY AND SURFACE SOIL	0 - 40	
SAND, SHALE AND RED BED	40 - 830	SYFO @ 500' - OK
ANHYDRITE	830 - 853	
RED BED	853 - 870	8-5/8" @ 868' w/625 SX. w/1/2 FLO-SEAL PER SK.
CEMENT	840 - 870	w/6 SX. C.C. - CEN. FOR L.C. @ BTM. SP w/100 SX.
RED BED AND SHALE	870 - 1415	PLUS 100% C.C. - SYFO @ 1000' - OK
SHALE AND SHELLS	1415 - 1785	SYFO @ 1500' - 1°
SHALE, SHELLS AND LIME	1785 - 1945	CEN. FOR L.C. - @ 1660' w/100 SX. + 2% C.C.
LIME	1945 - 2350	SYFO @ 2000' - OK
LIME	2350 - 2600	
LIME AND SHALE	2600 - 2720	
LIME AND SHALE	2720 - 3110	SYFO @ 2500' & 2950' - 1°
LIME	3110 - 3328	L.C. @ 3328' AND 3350' - CMTD. THRU OPEN END
LIME	3328 - 3353	PIPE - MADE 3 $\frac{1}{2}$ " - LOST AGAIN - CMTD. THRU OPEN END
LIME AND SHALE	3353 - 3395	DRILL PIPE - ON BOTTOM LOST CIRC. - CMTD. AT
LIME AND SHALE	3395 - 3478	BOTTOM OF SURFACE PIPE. LOST RETURNS - OPEN END
LIME	3478 - 3565	PIPE WOULD NOT GO BACK ON BOTTOM w/ BIT - CIRC.
LIME AND SHALE	3565 - 3780	OKAY.
LIME AND SHALE	3780 - 3805	
LIME	3805 - 3900	
LIME	3900 - 4005	
LIME	4005 - 4090	
LIME	4090 - 4150	
LIME AND CHERT	4150 - 4215	HOLE BRIDGING
LIME	4215 - 4275	
LIME	4275 - 4301	R.T.D. - CIRC. 20 HRS. 52 MIN., CONDITIONING
		HOLE - 5 $\frac{1}{2}$ " @ 4299 w/200 SX. -
		COMMON CEMENT

STATE OF KANSAS )  
COUNTY OF SEDGWICK ) ss.

I, E. H. SLOYER, DO HEREBY CERTIFY THAT THE ABOVE IS A TRUE AND ACCURATE LOG OF THE STRAIT WELL No. 9, LOCATED CTR. N $\frac{1}{2}$  SW $\frac{1}{4}$  SEC, SECTION 23-26S-13W, PRATT COUNTY, KANSAS.

E. H. Sloyer  
SECRETARY-TREASURER

SUBSCRIBED TO AND SWORN BEFORE ME THIS 6TH DAY OF JUNE, 1952.

Leona Pederson  
NOTARY PUBLIC

MY COMMISSION EXPIRES APRIL 20, 1955.