


WELL PLUGGING RECORD

Give All Information Completely  
Make Required Affidavit  
Mail or Deliver Report to:  
Conservation Division  
State Corporation Commission  
212 North Market, Insurance Bldg.  
Wichita, Kansas

Pratt County. Sec. 28 Twp. 26S Rge. 13W (E) (W)

Location as "NE/CNW/SW" or footage from lines C S/2 N/2 SE/4  
Lease Owner Sunray Mid-Continent Oil Company  
Lease Name Frisbie Well No. 3  
Office Address 321 West Douglas - Wichita, Kansas  
Character of Well (completed as Oil, Gas or Dry Hole) Oil  
Date well completed June 19, 1952  
Application for plugging filed February 24, 1960  
Application for plugging approved February 25, 1960  
Plugging commenced March 19, 1960  
Plugging completed March 25, 1960  
Reason for abandonment of well or producing formation Depleted

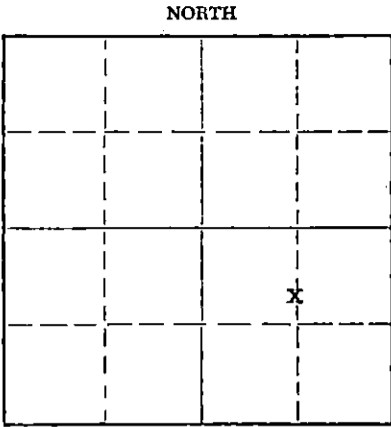

Locate well correctly on above Section Plat

If a producing well is abandoned, date of last production March 1, 1960  
Was permission obtained from the Conservation Division or its agents before plugging was commenced? Yes

Name of Conservation Agent who supervised plugging of this well Fred Hampel  
Producing formation Viola Depth to top \_\_\_\_\_ Bottom \_\_\_\_\_ Total Depth of Well 4510 Feet  
Show depth and thickness of all water, oil and gas formations.

OIL, GAS OR WATER RECORDS

CASING RECORD

FORMATION	CONTENT	FROM	TO	SIZE	PUT IN	PULLED OUT
Lansing	Water	3788	4004	13-3/8"	267	0
Mississippi	Dry	4204	4234	8-5/8"	1161	0
Viola	Oil	4267	4344	5-1/2"	4509	2662
Arbuckle	Water	4457	4510			

Describe in detail the manner in which the well was plugged, indicating where the mud fluid was placed and the method or methods used in introducing it into the hole. If cement or other plugs were used, state the character of same and depth placed, from \_\_\_\_\_ feet to \_\_\_\_\_ feet for each plug set.

Rock and mud to 4200' - 4 sack cement plug @ 4200'  
Bridge and 20 sack cement plug @ 270' to 300'  
Bridge and 10 sack cement plug @ 40' to surface  
Hole was filled with rock and mud and steel plate welded on top of surface pipe.

RECEIVED  
STATE CORPORATION COMMISSION

APR 5 1960

CONSERVATION DIVISION  
Wichita, Kansas

(If additional description is necessary, use BACK of this sheet)  
Name of Plugging Contractor Toland & Reeves  
Address Box 4336 - Oklahoma City, Oklahoma

STATE OF Kansas, COUNTY OF Sedgwick, ss.  
Nash A. Gough (employee of owner) or (owner or operator) of the above-described well, being first duly sworn on oath, says: That I have knowledge of the facts, statements, and matters herein contained and the log of the above-described well as filed and that the same are true and correct. So help me God.

(Signature) Nash A. Gough  
321 West Douglas - Wichita, Kansas  
(Address)

SUBSCRIBED AND SWORN TO before me this 4th day of April, 19 60

My commission expires July 13, 1963

W. E. Montgomery  
Notary Public.

COPY


WELL LOG BUREAU—KANSAS GEOLOGICAL SOCIETY  
508 East Murdock, Wichita, Kansas

Company- SUNRAY OIL CORPORATION  
Farm- Fred Frisbie No. 3

SEC. 28 T. 26 R. 13W  
CS<sup>1</sup>/<sub>2</sub> N<sup>1</sup>/<sub>2</sub> SE

Total Depth. 4510  
Comm. 5-16-52 Comp. 6-6-52  
Shot or Traced.  
Contractor. Stickle Drilling Co.  
Issued. 9-13-52

County Pratt  
KANSAS

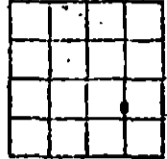

CASING:  
8 5/8" 1161' cem w/350 sx  
5 1/2" 4509'

Elevation. 1948  
Phys.  
Production. 266 BOPD & no wtr

Figures indicate Bottom of Formations.

sand, clay	65
sand	85
clay	100
sand	175
shale	190
red bed	715
red bed shale	860
red bed	910
anhydrite	920
shale	1045
shale, shells	1365
shale	1875
lime	2405
lime, shale	2600
lime	2680
shale	2880
lime	2992
shale	2960
shale, lime	3045
shale, shells	3225
lime, shale	3765
lime	4150
lime, chert	4170
lime cherty	4205
lime	4285
lime, shale	4304
lime	4350
lime, chert	4382
lime, shale	4445
lime	4510 RTD
Total Depth	

Tops:	
Lansing	3788
Miss.	4204
Viola	4267
Simpson	4373
Arbuckle	4457

DST 4226-34 open 1 hr., Rec.  
30' m, 660 FG #525,

DST 4269-85 open 1 hr. Gas 7"  
rec. 3700 GO #1080;

CO 4465; 19/4332-38 swz. 15/  
4315-20 PB 4305; 46/4269-84; 500-A;  
Hydrafrac:/