

STATE OF KANSAS
STATE CORPORATION COMMISSION


Give All Information Completely
Make Required Affidavit
Mail or Deliver Report to:
Conservation Division
State Corporation Commission
212 North Market, Insurance Bldg.
Wichita, Kansas

WELL PLUGGING RECORD

Pratt County. Sec. 28 Twp. 26S Rge. 13W (E) (W)

Location as "NE/CNWxSWx" or footage from lines C NW NW SE
Lease Owner Sunray Mid-Continent Oil Company
Lease Name Frisbie Well No. 1
Office Address 321 West Douglas - Wichita, Kansas
Character of Well (completed as Oil, Gas or Dry Hole) Oil
Date well completed October 9, 19 51
Application for plugging filed February 24, 19 60
Application for plugging approved February 25 19 60
Plugging commenced March 3 19 60
Plugging completed March 11 19 60
Reason for abandonment of well or producing formation Depleted

NORTH

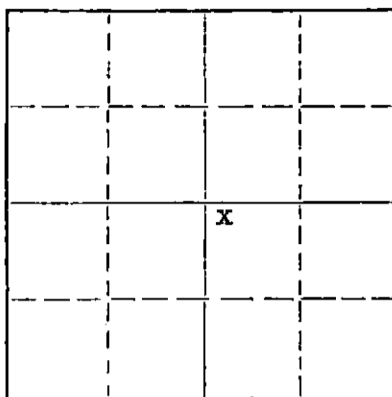

Locate well correctly on above
Section Plat

If a producing well is abandoned, date of last production January 19 59
Was permission obtained from the Conservation Division or its agents before plugging was commenced? Yes

Name of Conservation Agent who supervised plugging of this well Fred Hampel
Producing formation Viola Depth to top 4238 Bottom 4270 Total Depth of Well 4500 Feet
Show depth and thickness of all water, oil and gas formations.

OIL, GAS OR WATER RECORDS

CASING RECORD

FORMATION	CONTENT	FROM	TO	SIZE	PUT IN	PULLED OUT
Heebner	Dry	3604	3630	5 1/2"	4498	3489
Lansing, K.C.	Water	3785	4060	8-5/8"	915	0
Miss. Viola	Dry	4196	4220	13-3/8"	269	0
Viola	Oil - Depleted	4238	4270			
Simpson	Dry	4344	4380			
Arbuckle	Water	4436	TD			

Describe in detail the manner in which the well was plugged, indicating where the mud fluid was placed and the method or methods used in introducing it into the hole. If cement or other plugs were used, state the character of same and depth placed, from _____ feet to _____ feet for each plug set.

- (1) 20 sack cement plug 270' - to 300'
 - (2) 10 sack cement plug 40' to surface
 - (3) Steel plate was welded on top of surface pipe.
- Hole was filled with mud.

RECEIVED
STATE CORPORATION COMMISSION

MAR 18 1960

CONSERVATION DIVISION
Wichita, Kansas

(If additional description is necessary, use BACK of this sheet)

Name of Plugging Contractor Toland & Reeves
Address Box 4336 - Oklahoma City, Oklahoma

STATE OF Kansas, COUNTY OF Sedgwick, ss.
Nash A. Gough (employee of owner) or (owner or operator) of the above-described well, being first duly sworn on oath, says: That I have knowledge of the facts, statements, and matters herein contained and the log of the above-described well as filed and that the same are true and correct. So help me God.

(Signature) Nash A. Gough
321 West Douglas - Wichita, Kansas
(Address)

SUBSCRIBED AND SWORN TO before me this 16 day of March, 1960

My commission expires July 13, 1963
Wm. Montgomery Notary Public.

Fred FRISBIE "A" #1

Casing Record:
 13-3/8" - 270'
 8-5/8" - 916'
 5-1/2" - 4500'

Company: Sunray Oil Corporation
 Contractor: Aylward Drilling Company
 Commenced: August 31, 1951
 Completed: October 3, 1951

Description:
 NW NW SE of
 Sec. 28-26S-13W,
 Pratt County, Kansas

<u>Formation</u>	<u>From</u>	<u>To</u>	<u>Remarks</u>
Surface Soil Clay	0	28	
Sand & Gravel	28	205	
Red Bed	205	243	
Hard Shale	243	262	
Shale	262	270	13-3/8" Casing set @ 270', and cemented with 300 sax.
Shale & Shells	270	410	
Red Bed	410	895	
Anhy. Shaly	895	916	
Red Bed	916	1030	8-5/8" casing set @ 916', and cemented with 500 sax.
Shale & Shells	1030	1435	
Salt	1435	1620	
Shale	1620	1745	
Shale & Shells	1745	1800	
Lime	1800	1970	
Sandy Lime	1970	2085	
Lime	2085	2240	
Sandy Lime Soft	2240	2270	
Shale	2270	2280	
Lime Sandy	2280	2385	
Lime & Shale	2385	3089	
Lime	3080	3165	
Lime & Shale	3165	3310	
Lime	3310	3580	
Lime & Shale	3580	3665	
Shale & Shells	3665	3705	
Lime & Shale	3705	3795	
Lime	3795	3945	
Lime & Shale Bks. & Cherty	3945	3965	
Lime	3965	4062	
Lime & Shale	4062	4100	
Lime	4100	4210	
Shale & Lime	4210	4250	
Chert Lime	4250	4270	
Lime	4270	4280	
Lime & Chert	4280	4320	
Cherty Lime	4320	4343	
Chert	4343	4346	
Sandy Shale	4346	4430	
Lime	4430	4500	Set 5 1/2" Casing @ 4500', and cemented with 125 sax. - T.D. 4500'

RECORDED
 STATE CORPORATE COMMISSION
 MAR 18 1960
 CONSERVATION DIVISION
 Wichita, Kansas

I certify that this is a true and correct copy of the above log.

Subscribed and sworn to before me this 8 day of October, 1951.

My Commission Expires

April 25, 1953

[Signature]

[Signature]

 Notary Public