


Give All Information Completely  
Make Required Affidavit  
Mail or Deliver Report to:  
Conservation Division  
State Corporation Commission  
212 No. Market  
Wichita, Kansas

WELL PLUGGING RECORD

Pratt County, Sec. 28 Twp. 26 Rge. (E) 13 (W)

Location as "NE/CNW/SW" or footage from lines 0 E/2 SW SW  
Lease Owner Rine Drilling Company, Inc.  
Lease Name Strait Well No. 8  
Office Address Suite 600, 300 W. Douglas, Wichita, Kansas  
Character of Well (completed as Oil, Gas or Dry Hole) oil  
Date well completed \_\_\_\_\_ 19 \_\_\_\_  
Application for plugging filed April 9 19 70  
Application for plugging approved \_\_\_\_\_ 19 \_\_\_\_  
Plugging commenced April 20 19 70  
Plugging completed April 23 19 70  
Reason for abandonment of well or producing formation depleted

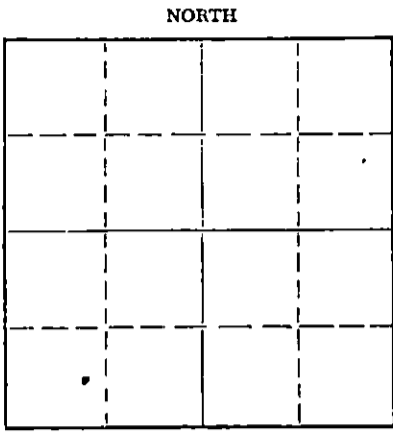

Locate well correctly on above Section Plat

If a producing well is abandoned, date of last production \_\_\_\_\_ 19 \_\_\_\_  
Was permission obtained from the Conservation Division or its agents before plugging was commenced? yes

Name of Conservation Agent who supervised plugging of this well Ralph Warren  
Producing formation \_\_\_\_\_ Depth to top \_\_\_\_\_ Bottom \_\_\_\_\_ Total Depth of Well 4354 Feet  
Show depth and thickness of all water, oil and gas formations.

OIL, GAS OR WATER RECORDS

CASING RECORD

FORMATION	CONTENT	FROM	TO	SIZE	PUT IN	PULLED OUT
		0	863'	8 5/8"	863'	none
		0	4353'	5 1/2"	4353'	2730.64

Describe in detail the manner in which the well was plugged, indicating where the mud fluid was placed and the method or methods used in introducing it into the hole. If cement or other plugs were used, state the character of same and depth placed, from \_\_\_\_\_ feet to \_\_\_\_\_ feet for each plug set.

Sanded back to 4300' and dumped 5 sacks of cement.

Squeezed well with 15 sacks of mud and 100 sacks of cement.

RECEIVED  
STATE CORPORATION COMMISSION  
APR 29 1970  
CONSERVATION DIVISION  
Wichita, Kansas

(If additional description is necessary, use BACK of this sheet)  
Name of Plugging Contractor PIPE PULLERS, INC.  
Address Box 486, Ellinwood, Kansas

STATE OF Kansas, COUNTY OF Barton, ss.  
Evelyn Roth (employee of owner) or (owner or operator) of the above-described well, being first duly sworn on oath, says: That I have knowledge of the facts, statements, and matters herein contained and the log of the above-described well as filed and that the same are true and correct. So help me God.

(Signature) Evelyn Roth  
Ellinwood, Kansas  
(Address)

SUBSCRIBED AND SWORN TO before me this 28th day of April, 19 70

My commission expires Feb. 10, 1971

George A. Meyer  
Notary Public.

WELL LOG BUREAU - KANSAS GEOLOGICAL SOCIETY  
 508 East Murdock, Wichita, Kansas

*UHY*

Company: LION OIL CO.  
 Farm: Strait No. 8

SEC. 28 T. 26 R. 13W  
 CE/2 SW SW

County: Pratt  
 KANSAS


Total Depth. 4354  
 Comm. 8-8-51  
 Shot or Treated.  
 Contractor.  
 Issued. 11-29-52

Comp. 8-24-51

**RECEIVED**

MAR 31 1970

RINE DRILLING CO.

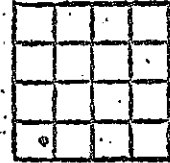

**CASING:**

9 5/8" 863' cem. w/600 sx.  
 5 1/2" 4353' cem. w/200 sx.

Elevation. \_\_\_\_\_

Production. 373 bbls.

Figures indicate Bottom of Formations.

sand, clay	320
red bed	370
red bed & sand	523
shale & shells	1530
salt, shale, shells	1754
shale & lime	2575
lime brkn & shale	2725
shale & lime	3370
lime brkn	3580
lime & shale	3810
shale	3835
lime	3929
shale & lime	4000
lime	4090
lime & shale	4170
lime, chert, & shale	4190
shale & lime	4230
lime, shale, chert	4315
shale & chert	4330
shale & lime	4354
Total Depth	

Tops: Scout  
 Mississippi 4238  
 Viola 4347

**RECEIVED**  
 STATE CORPORATION COMMISSION  
 APR 10 1970  
 CONSERVATION DIVISION  
 Wichita, Kansas