


STATE OF KANSAS
 STATE CORPORATION COMMISSION
 Give All Information Completely
 Make Required Affidavit
 Mail or Deliver Report to:
 Conservation Division
 State Corporation Commission
 800 Bittling Building
 Wichita, Kansas

WELL PLUGGING RECORD

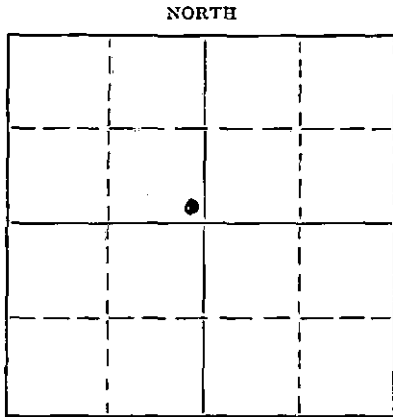

Locate well correctly on above Section Plat

Pratt County. Sec. 10 Twp. 26 Rge. (E) 13 (W)
 Location as "NE/CNW $\frac{1}{4}$ /SW $\frac{1}{4}$ " or footage from lines SE SE NW
 Lease Owner Francis Oil & Gas Company
 Lease Name Helzel Well No. 1
 Office Address 902 Palace Building, Tulsa, Oklahoma
 Character of Well (completed as Oil, Gas or Dry Hole) Dry Hole
 Date well completed 3-6-50 19
 Application for plugging filed 3-7-50 19
 Application for plugging approved 3-7-50 19
 Plugging commenced 3-7-50 19
 Plugging completed 3-7-50 19
 Reason for abandonment of well or producing formation

If a producing well is abandoned, date of last production 19
 Was permission obtained from the Conservation Division or its agents before plugging was commenced? Yes

Name of Conservation Agent who supervised plugging of this well Eldon Petty Great Bend, Kansas
 Producing formation Depth to top Bottom Total Depth of Well 1191 Feet
 Show depth and thickness of all water, oil and gas formations.

OIL, GAS OR WATER RECORDS

CASING RECORD

Formation	Content	From	To	Size	Put In	Pulled Out
				8-5/8	783	Cemented with 400 sacks.

Describe in detail the manner in which the well was plugged, indicating where the mud fluid was placed and the method or methods used in introducing it into the hole. If cement or other plugs were used, state the character of same and depth placed, from feet to feet for each plug set.

After circulating hole with heavy mud, put bridge at 250 ft. with 15 sacks of cement, filling hole with mud to 30' set plug and added ten sacks of cement.


(If additional description is necessary, use BACK of this sheet)

Correspondence regarding this well should be addressed to Francis Oil & Gas Company
 Address 902 Palace Building
 Tulsa, Oklahoma

STATE OF KANSAS, COUNTY OF MONTGOMERY, ss.
 Floyd W. Hild (employee of owner) or (owner or operator) of the above-described well,
 being first duly sworn on oath, says: That I have knowledge of the facts, statements, and matters herein contained and the log of the above-described well as filed and that the same are true and correct. So help me God.

(Signature) THE VEEDER SUPPLY & DEVELOPMENT COMPANY
 Floyd W. Hild
 P.O. Box 201, Cherryvale, Kansas
 (Address)

Subscribed and sworn to before me this 14th day of March, 1950.
 Les Lawson
 Notary Public.

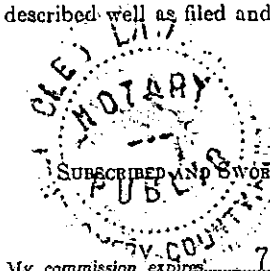

Company - Francis Oil & Gas Company, Inc.

Sec. 10 T. 263 R. 13W

Loc. SE, SE, SE, NW

Farm Helcol

No. 1

County Pratt - Kansas

10-26-13W

Total Depth 4491'

Comm. 2-12-50

Comp. 3-5-50

Shot or Treated

Contractor Weeders Supply Company

Drilled with Rig - A.

Issued

No. of Days - 22

No. of Bits

Casing

20 in.

10 in.

15 1/2

8 1/4

12 1/2

6 5/8

13 3/8

5 3/16

Set 707' of 8-5/8" Casing Cemented with 400 sacks cement

Elevation

Production

Figures Indicate Bottom of Formation

Surface Soil	0	130	130	Top K.C. - 3733'
Sand Gravel	130	165	35	
Red Red Sand Streaks	165	415	250	
Red Red	415	425	10	
Hard Brown Lino	425	433	8	
Red Red	433	565	132	
Red Red Sand Streaks	565	720	155	
Red Red	720	774	54	
Anhydrite	774	825	51	
Red Red Shale Shells	825	1055	230	
Shale Shells	1055	1490	435	
Shale	1490	1705	215	
Lime Shale	1705	1805	100	
Lime	1805	2100	375	
Sandy Lime	2100	2210	30	
Lime	2210	2230	20	
Lime Shale	2230	2345	115	
Shale Lime Shells	2345	2435	90	
Lime Shale	2435	2640	205	
Shale Shells	2640	2765	125	
Lime Shale	2765	3035	270	
Lime	3035	3125	90	
Lime Shale Breaks	3125	3195	70	
Lime	3195	3315	120	
Broken Lime	3315	3610	295	
Lime Shale Sand	3610	3730	120	
Lime	3730	3870	140	
Lime Cherty	3870	3885	15	
Lime	3885	4135	250	
Lime Shale	4135	4190	55	
Cherty Lime	4190	4207	17	
Lime	4207	4230	23	
Lime Chert	4230	4250	20	
Lime	4250	4280	30	
Lime Cherty	4280	4340	60	
Lime	4340	4355	15	
Cirpoon Lime	4355	4375	20	
Lime Shale	4375	4410	35	
Lime Shale Sand	4410	4460	35	
Arbuckle Lime	4460	4491	31	
T.D.	4491'			

RECEIVED

Co.

MAR 16 1950

PLUGGING OPERATION
 FILE SEC 10 T. 263 R. 13W
 BOOK PAGE 44 LINE 31