

EFFECTIVE DATE: 11-3-90

FORM MUST BE TYPED
FORM C-1 4/90

State of Kansas
NOTICE OF INTENTION TO DRILL

FORM MUST BE SIGNED
ALL BLANKS MUST BE FILLED

Must be approved by the K.C.C. five (5) days prior to commencing well

Expected Spud Date 10 28 90
month day year

SE. NW. SW. Sec 19 Twp 26 S, Rg 13 East West

1650 feet from South line of Section
4290 feet from East line of Section

(Note: Locate well on Section Plat on Reverse Side)

OPERATOR: License # 5435
Name: Bowers Drilling Co., Inc.
Address: 125 N. Market, Suite 1425
City/State/Zip: Wichita, KS 67202
Contact Person: Jack L. Partridge
Phone: (316) 262-1841

County: Pratt
Lease Name: McMannis Well #: 1
Field Name: Unknown

CONTRACTOR: License # 5422
Name: Abercrombie Drilling, Inc.

Is this a Prorated Field? yes no

Target Formation(s): Simpson
Nearest lease or unit boundary: 990'
Ground Surface Elevation: Unknown feet MSL

Well Drilled For: Well Class: Type Equipment:
 Oil ... Inj ... Infield Mud Rotary
... Gas ... Storage ... Pool Ext. ... Air Rotary
... OWMO ... Disposal Wildcat ... Cable
... Seismic; ... # of Holes

Domestic well within 330 feet: yes no

Municipal well within one mile: yes no

Depth to bottom of fresh water: 130'

Depth to bottom of usable water: 200'

Surface Pipe by Alternate: 1 2

Length of Surface Pipe Planned to be set: 265'

Length of Conductor pipe required: None

Projected Total Depth: 4450'

Formation at Total Depth: Simpson

Water Source for Drilling Operations:
 well farm pond other

If OWMO: old well information as follows:
Operator: N/A
Well Name: _____
Comp. Date: _____ Old Total Depth _____

DWR Permit #: Will File

Will Cores Be Taken?: yes no

Directional, Deviated or Horizontal wellbore? yes no
If yes, total depth location: _____

If yes, proposed zone: _____

AFFIDAVIT

The undersigned hereby affirms that the drilling, completion and eventual plugging of this well will comply with K.S.A. 55-101, et. seq.

It is agreed that the following minimum requirements will be met:

1. The appropriate district office shall be notified before setting surface pipe;
2. The minimum amount of surface pipe as specified above shall be set by circulating cement to the top; in all cases surface pipe shall be set through all unconsolidated materials plus a minimum of 20 feet into the underlying formation;
3. If the well is dry, a plugging proposal shall be submitted to the district office. An agreement between the operator and the district office on plug length and placement is necessary prior to plugging;
4. The appropriate district office will be notified before well is either plugged or production casing is cemented in;
5. If an Alternate II completion, production pipe shall be cemented from below any usable water to surface within 120 days of spud date. In all cases, notify district office prior to any cementing.

I hereby certify that the statements made herein are true and to the best of my knowledge and belief.

Date: 10-23-1990 Signature of Operator or Agent: Jack L. Partridge Title: VP, Abercrombie Drllg, Inc.

FOR KCC USE:

API # 15- 151-22,017-00-00

Conductor pipe required None feet

Minimum surface pipe required 230 feet per Alt. (P)

Approved by: MLW 10-29-90

EFFECTIVE DATE: 11-3-90

This authorization expires: 4-29-91
(This authorization void if drilling not started within 6 months of effective date.)

Spud date: _____ Agent: _____

RECEIVED
STATE CORPORATION COMMISSION
OCT 25 1990
CONSERVATION DIVISION
Wichita, Kansas

19
26
1310

REMEMBER TO:


- File Drill Pit Application (form CDP-1) with Intent to Drill;
- File Completion Form ACD-1 within 120 days of spud date;
- File acreage attribution plat according to field proration orders;
- Notify appropriate district office 48 hours prior to workover or re-entry;
- Submit plugging report (CP-4) after plugging is completed;
- Obtain written approval before disposing or injecting salt water.

PLAT OF ACREAGE ATTRIBUTABLE TO A WELL

State Corporation Commission, Conservation Division
200 Colorado Derby Bldg. Wichita, Kansas 67202

OPERATOR Bowers Drilling Co., Inc. LOCATION OF WELL:
 LEASE McMannis 1650 feet north of SE corner
 WELL NUMBER 1 4290 feet west of SE corner
 FIELD Unknown Sec. 19 T 26 R 13 ~~EW~~
 COUNTY Pratt
 NO. OF ACRES ATTRIBUTABLE TO WELL 10 IS SECTION X REGULAR IRREGULAR?
 DESCRIPTION OF ACREAGE SE/4 NW/4 SW/4 IF IRREGULAR, LOCATE WELL FROM NEAREST
 CORNER BOUNDARY.

NOTE: If plat depicted is insufficient for your circumstances, you may attach your own scaled or surveyed plat.

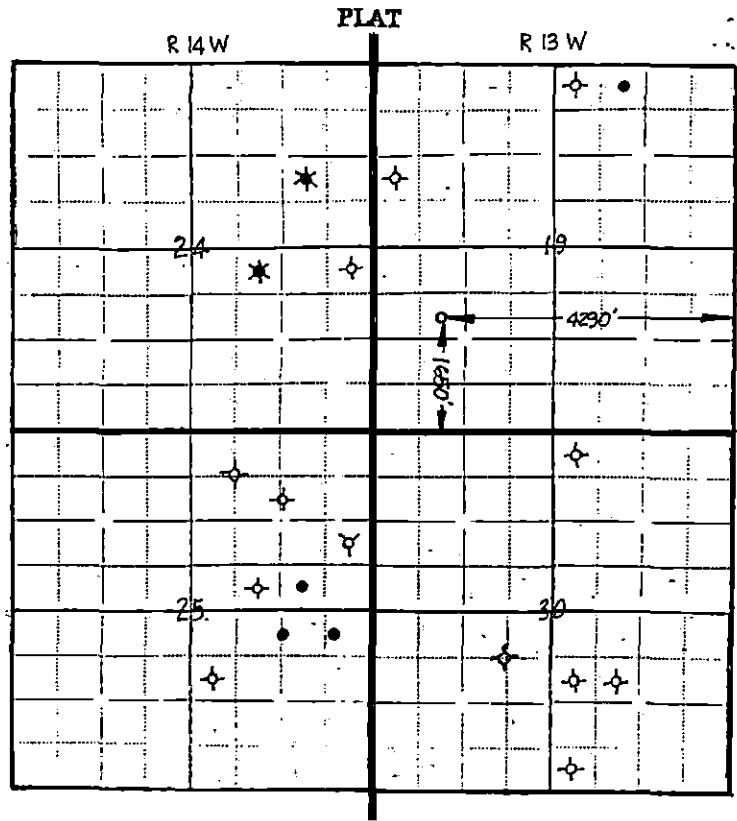

In plotting the proposed location of the well, you must show:

- 1) The manner in which you are using the depicted plat by identifying section lines, i.e. 1 section, 1 section with 8 surrounding partial sections, 4 sections, 16 sections, etc.;
- 2) the well's location relative to the location of other wells producing from the same common source of supply in adjoining drilling units, pursuant to K.A.R. 82-3-108, 82-3-207, 82-3-312, or special orders of the Commission;
- 3) the distance of the proposed drilling location from the section's east and south lines; and
- 4) the distance to the nearest lease or unit boundary line.

I hereby certify that the statements made herein are true and to the best of my knowledge and belief.

Signature of Operator or Agent Paul L. Partch
 Date 10-23-90 Title VP, Abercrombie Drilling, Inc.